

UNION
F46
2-13-74

MISSISSIPPI
BOARD OF WATER COMMISSIONERS
416 North State Street
Jackson, Mississippi 39201

CODED

WATER WELL DRILLERS LOG

2 13 19 74 date well completed
J. Maddox firm name
Union county well located

LANDOWNER: James Davis
Myrtle R.I.
38652
(mailing address)

description of formations encountered	from	to
Red clay	0	8
white clay	8	360
rock & sand	360	460

WELL LOCATION:
sec. 6 T 7 N R 4 E
4 miles S of Fayette
(distance) (direction) (nearest town)

WELL PURPOSE:
(home, irrigation, municipal, industrial)

WELL COMPLETION DATA:

(1) diameter (inches) 4

(2) total depth (feet) 460

(3) static water level (feet) 40 below top of ground.

(4) casing P 100 (material) (depth)

(size) if telescope see back.

(5) screen 10 (length) (depth to top)

(size) (material)

(6) pump 1/2 10 (HP) (yield gpm)


(type power)

(7) electric log (yes or no)

(organization running log)

(8) how well bottom plugged

CODED

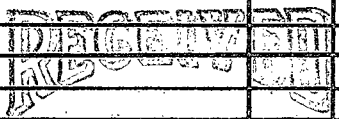


AUG 15 1974

DRILLERS REMARKS:

If well telescopes please sketch and show depths.

GROUND LEVEL

Handwritten notes:
 00000000
 00000000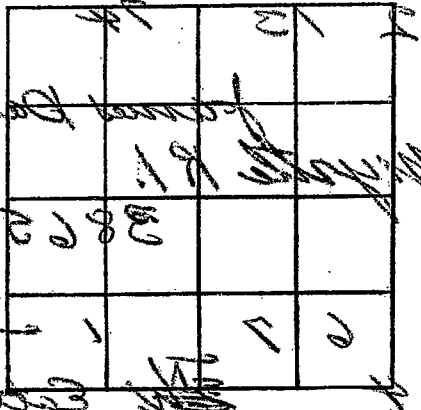
SECTION *X*

Please indicate well location X.

ADDITIONAL INFORMATION

Handwritten entries in the additional information section:

1

2

If more than one screen, show locations of each on sketch.