

UNION  
F47  
5-6-74

MISSISSIPPI  
BOARD OF WATER COMMISSIONERS  
416 North State Street  
Jackson, Mississippi 39201

CODED

WATER WELL DRILLERS LOG

56 1974 J.T. Muller UNION  
date well completed firm name county well located

LANDOWNER: Terry & Baker  
New Albany  
HW 30 Road Paducah, Mo.  
(mailing address)

description of formations encountered  
Clay  
18" 240  
rock sand 240 360

from to

WELL LOCATION:  
sec. 17 T. 2 N. R. 1 E.  
2 miles N of Paducah, Mo.  
(distance) (direction) (nearest town)

WELL PURPOSE:  
(home, irrigation, municipal, industrial)

WELL COMPLETION DATA:

(1) diameter (inches) 4

(2) total depth (feet) 360

(3) static water level (feet) 60 below top of ground.

(4) casing P, 100 (material) (depth)

(size) if telescope see back.

(5) screen a (length) (depth to top)

(size) (material)

(6) pump 3/4 6 (HP) (yield gpm)

(type power)

(7) electric log (yes or no)

(organization running log)

(8) how well bottom plugged


CODED

RECEIVED  
MAY 15 1974

DRILLERS REMARKS:

If well telescopes please sketch and show depths.

GROUND LEVEL

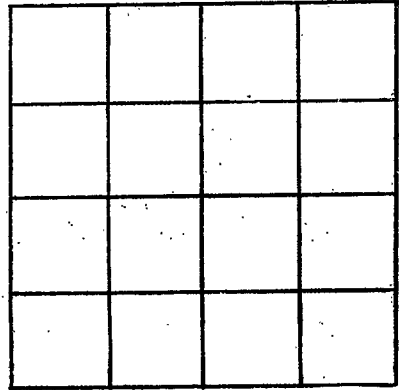

SECTION \_\_\_\_\_

Please indicate well location X.

ADDITIONAL INFORMATION

If more than one screen, show locations of each on sketch.