

UNION
F48
8-2-74

MISSISSIPPI
BOARD OF WATER COMMISSIONERS
416 North State Street
Jackson, Mississippi 39201

CODED

WATER WELL DRILLERS LOG

Aug. 2 1974 Babby L. Swartz Union
date well completed firm name county well located

LANDOWNER: H.S.
Henry
New Albany, Miss.
(mailing address)

description of formations encountered	from	to
Red clay	0	40
Blue mud	40	400
Rock Sand	400	509


WELL LOCATION:
sec. 11 T. 7 R. 1
15 miles W of New Albany
(distance) (direction) (nearest town)

WELL PURPOSE: Cabin
(home, irrigation, municipal, industrial)

WELL COMPLETION DATA:

- diameter (inches) 4"
- total depth (feet) 509
- static water level (feet) 30 below top of ground.
- casing Steel, 68' (material), (depth)
4" (size) if telescope see back.
- screen none (length), (depth to top)
(size), (material)
- pump (HP), (yield gpm)
(type power)
- electric log (yes or no)
(organization running log)
- how well bottom plugged


DRILLERS REMARKS:

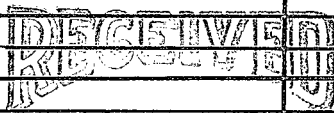

AUG 21 1974

If well telescopes please sketch and show depths.

GROUND LEVEL

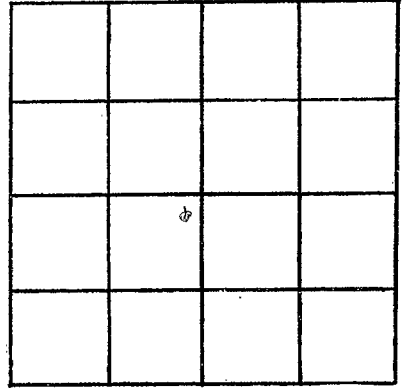

SECTION 10

Please indicate well location X.

ADDITIONAL INFORMATION

If more than one screen, show locations of each on sketch.