

Union
F 49
6-12-75

MISSISSIPPI
BOARD OF WATER COMMISSIONERS
416 North State Street
Jackson, Mississippi 39201

\$1180.00
TAX CODED

WATER WELL DRILLERS LOG

6 12 1975 date well completed
J F Medlin firm name
Union county well located

LANDOWNER: Mitchell
Summer
R.P. Etna
(mailing address)

description of formations encountered	from	to
Clay	0	3.90
rock (sand)	3.90	9.40

WELL LOCATION:
sec. 30 T. 2 N R. 1 E 15F
3 miles NW of Pinedale
(distance) (direction) (nearest town)

WELL PURPOSE:
(home, irrigation, municipal, industrial)


- WELL COMPLETION DATA:
- (1) diameter (inches) 4
 - (2) total depth (feet) 470
 - (3) static water level (feet) 65 below top of ground.
 - (4) casing P, 120, (material) (depth)
 - (size) if telescope see back.
 - (5) screen (length) (depth to top)
 - (size) (material)
 - (6) pump 24 (HP) 6 (yield gpm)
 - (type power)
 - (7) electric log (yes or no)
 - (organization running log)
 - (8) how well bottom plugged

DRILLERS REMARKS:

RECEIVED
JUL - 9 1975

If well telescopes please sketch and show depths.

GROUND LEVEL

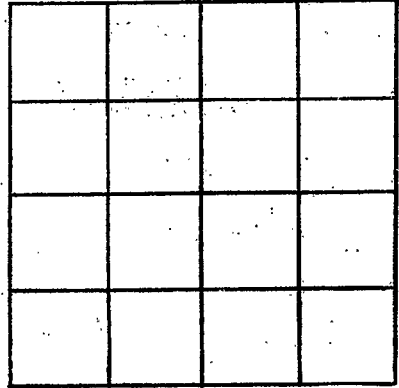

SECTION _____

Please indicate well location X.

ADDITIONAL INFORMATION

If more than one screen,
show locations of each on sketch.