

MISSISSIPPI
BOARD OF WATER COMMISSIONERS
416 North State Street
Jackson, Mississippi 39201

11

UNION
F50
9-22-75

15F

WATER WELL DRILLERS LOG

Sept. 22, 1975 J.T. Meelin Union
date well completed firm name county well located


LANDOWNER:	description of formations encountered	from	to
Sonny Goolsby New ALBANY (mailing address)			
WELL LOCATION: sec. 14 7 N (R) 1 E 3 miles W Enterprise (distance) (direction) (nearest town)	CLAY	0	280
WELL PURPOSE: (Home, irrigation, municipal, industrial)	Rock & SAND	380	400
WELL COMPLETION DATA: (1) diameter (inches) 4			
(2) total depth (feet) 400 ft.			
(3) static water level (feet) 60 below top of ground.			
(4) casing P 125 ft. (material) (depth)			
(size) if telescope see back.			
(5) screen (length) (depth to top)			
(size) (material)			
(6) pump 1/2 8 (HP) (yield gpm)	1 1/2 miles past West Union school on right		
(7) electric log E (yes or no)			
(organization running log)			
(8) how well bottom plugged			
DRILLERS REMARKS:			

RECORDED
INDEXED
OCT 13 1975

MISS. BD. OF WATER COMMISSIONERS

If well telescopes please sketch and show depths.

GROUND LEVEL

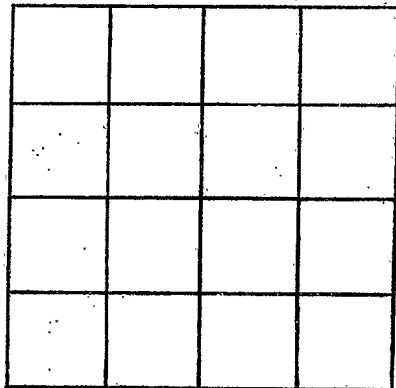

SECTION _____

Please indicate well location X.

ADDITIONAL INFORMATION

If more than one screen,
show locations of each on sketch.