

**MISSISSIPPI  
BOARD OF WATER COMMISSIONERS**  
416 North State Street  
Jackson, Mississippi 39201

**WATER WELL DRILLERS LOG**

**Union**  
**F 2000**  
**1-6-76**

15F

date well completed

firm name

county well located

1-6-76 1976 J. T. Mullin Union


LANDOWNER:	description of formations encountered	from	to
Duke Martin	Top soil	0	10
Ettie Miss (mailing address)	Mud & Rocks	120	300
WELL LOCATION:	Sand & Shell	300	400
sec. <u>1907</u> <u>N</u> <u>R</u> <u>E</u> <u>1</u> miles <u>S</u> of <u>Ettie</u> (distance) (direction) (nearest town)			
<b>WELL PURPOSE:</b> (home, irrigation, municipal, industrial)			
<b>WELL COMPLETION DATA:</b>			
(1) diameter (inches) <u>4 inch</u>			
(2) total depth (feet) <u>400</u>			
(3) static water level (feet) <u>160</u> below above top of ground.			
(4) casing <u>Galv</u> <u>180</u> (material) (depth)			
_____ if telescope see back. (size)			
(5) screen _____ (length) (depth to top)			
_____ (size) _____ (material)			
(6) pump <u>1/2 HP</u> <u>7 1/2</u> (HP) (yield gpm)			
<u>Electric</u> (type power)			
(7) electric log _____ (yes or no)			
_____ (organization running log)			
(8) how well bottom plugged _____			
<b>DRILLERS REMARKS:</b>			

**RECEIVED**  
**MS**

FEB 2 - 1976

If well telescopes please  
sketch and show depths.

GROUND LEVEL

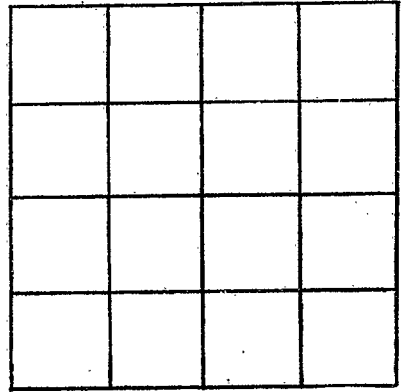

SECTION \_\_\_\_\_

Please indicate well location X.

ADDITIONAL INFORMATION

If more than one screen,  
show locations of each on sketch.