

UNION
 F 2001
 1-31-76

MISSISSIPPI
 BOARD OF WATER COMMISSIONERS
 416 North State Street
 Jackson, Mississippi 39201

WATER WELL DRILLERS LOG

1-31-76 date well completed 1976 J. Wilkerson firm name Union county well located

LANDOWNER: Mrs Ruth Wood
 Booneville, Miss
 (mailing address)

description of formations encountered	from	to
Soil	0	1
Sand & Clay	1	30
Blue Rock	30	450
Rock & sand	450	560
Replay Sand		

WELL LOCATION:
 sec. 12 T. 70 N R. 1 E
 1/4 miles East of Etta
 (distance) (direction) (nearest town)

WELL PURPOSE:
 (home, irrigation, municipal, industrial)

WELL COMPLETION DATA:

- (1) diameter (inches) 4
- (2) total depth (feet) 560
- (3) static water level (feet) 52 below top of ground.
- (4) casing Steel, 105 (material), (depth)
 (size) if telescope see back.
- (5) screen 0 (length), 2 (depth to top)
 (size) (material)
- (6) pump 1/2 HP Sub 8 (HP) (yield gpm)
 Elec (type power)
- (7) electric log (yes or no)
 (organization running log)
- (8) how well bottom plugged Open


RECEIVED
 MAR 4 1976

MISS. RD. OF WATER COMMISSIONERS

DRILLERS REMARKS:

If well telescopes please sketch and show depths.

GROUND LEVEL

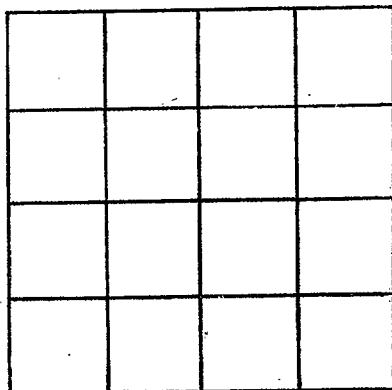

SECTION _____

Please indicate well location X.

ADDITIONAL INFORMATION

If more than one screen,
show locations of each on sketch.