

UNION
F 2003
6-7-77

MISSISSIPPI
BOARD OF WATER COMMISSIONERS
416 North State Street
15F Jackson, Mississippi 39201

WATER WELL DRILLERS LOG

Medlin Well Drilling Union
date well completed 6-7-77 19 firm name county well located

LANDOWNER:
William Puckett
Myrtle Ms.
(mailing address)

description of formations encountered	from to	
	feet	feet
Cherty Clay	0	50
Blue Clay	50	330
Sand & Rock	330	390

WELL LOCATION:
sec. 2 T. 7 N. R. 1 E.
1/2 miles South Myrtle
(distance) (direction) (nearest town)

WELL PURPOSE:
(home, irrigation, municipal, industrial)

WELL COMPLETION DATA:

(1) diameter (inches) 4

(2) total depth (feet) 390

(3) static water level (feet) 105 below top of ground.

(4) casing 140 Pha. (material) (depth)
(size) If telescope see back.

(5) screen (length) (depth to top)
(size) (material)

(6) pump 1/2 Sub. 9 (HP) (yield gpm)
(type power)

(7) electric log (yes or no)
(organization running log)

(8) how well bottom plugged Open


DRILLERS REMARKS:

RECEIVED
SEP 29 1977

MISS. BD. OF WATER COMMISSIONERS

If well telescopes please sketch and show depths.

GROUND LEVEL

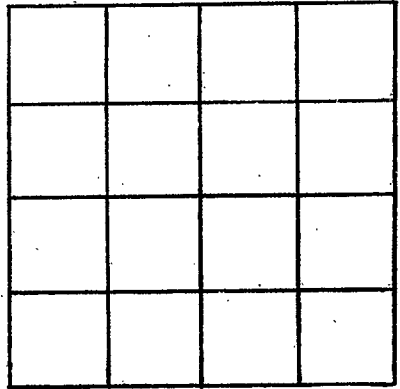

SECTION _____

Please indicate well location X.

ADDITIONAL INFORMATION

If more than one screen, show locations of each on sketch.