

UNION
 F 2004
 10-29-77

MISSISSIPPI
 BOARD OF WATER COMMISSIONERS
 416 North State Street
 Jackson, Mississippi 39201

WATER WELL DRILLERS LOG

10-29 date well completed
 15F 1977 Bryants Well Drilling firm name
 UNION county well located


LANDOWNER:	description of formations encountered	from	to
Jack MATEY Etta M.C. (mailing address)			
WELL LOCATION: sec. <u>1</u> T <u>7</u> N <u>1</u> E <u>3</u> miles <u>WEST</u> of <u>Enterprise</u> (distance) (direction) (nearest town)			
WELL PURPOSE: (home, irrigation, municipal, industrial)			
WELL COMPLETION DATA: (1) diameter (inches) <u>4"</u> (2) total depth (feet) <u>500'</u> (3) static water level (feet) <u>80'</u> ^{below} _{above} top of ground. (4) casing <u>PLAS.</u> <u>135'</u> (material) (depth) (size) if telescope see back. (5) screen _____ (length) _____ (depth to top) (size) _____ (material) _____ (6) pump <u>1/2 sub.</u> <u>10</u> (HP) (yield gpm) (type power) _____ (7) electric log _____ (yes or no) (organization running log) _____ (8) how well bottom plugged <u>OPEN</u>			
DRILLERS REMARKS:			

RECEIVED
 NOV 21 1977

MISS. BD. OF WATER COMMISSIONERS

If well telescopes please sketch and show depths.

GROUND LEVEL

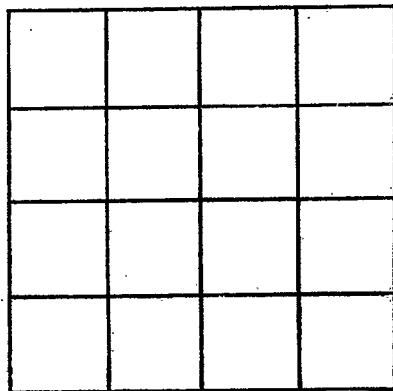

SECTION _____

Please indicate well location X.

ADDITIONAL INFORMATION

If more than one screen, show locations of each on sketch.