

UNION
F 2005

**MISSISSIPPI  
BOARD OF WATER COMMISSIONERS**  
416 North State Street  
Jackson, Mississippi 39201

**WATER WELL DRILLERS LOG**

3-14-78      19 Bryants Well Drilling      Union  
 date well completed      firm name      county well located

**LANDOWNER:**  
Carral M. ~~Wally~~  
Ethan Miss  
 (mailing address)


description of formations encountered	from	to
<u>Mipel Clay</u>	<u>0</u>	<u>45</u>
<u>Blue Clay</u>	<u>45</u>	<u>470</u>
<u>Clay &amp; Red R</u>	<u>400</u>	<u>450</u>
<u>Shell &amp; Rock</u>	<u>450</u>	<u>530</u>

**WELL LOCATION:**  
 sec. 1 T. 7 N. R. 1 E  
10 miles West of New Albany  
 (distance) (direction) (nearest town)

**WELL PURPOSE:** Home  
 (home, irrigation, municipal, industrial)

- WELL COMPLETION DATA:**
- (1) diameter (inches) 4"
  - (2) total depth (feet) 530
  - (3) static water level (feet) 100 below top of ground.
  - (4) casing Flex. 145  
 (material) (depth)  
 (size) if telescope see back.
  - (5) screen \_\_\_\_\_  
 (length) (depth to top)  
 (size) (material)
  - (6) pump 1/2 7  
 (HP) (yield gpm)  
Elco  
 (type power)
  - (7) electric log \_\_\_\_\_  
 (yes or no)  
 (organization running log)
  - (8) how well bottom plugged Open


**DRILLERS REMARKS:**  
 \_\_\_\_\_  
 \_\_\_\_\_  
 \_\_\_\_\_

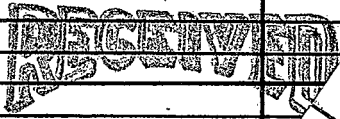

AUG - 9 1978

If well telescopes please sketch and show depths.

GROUND LEVEL

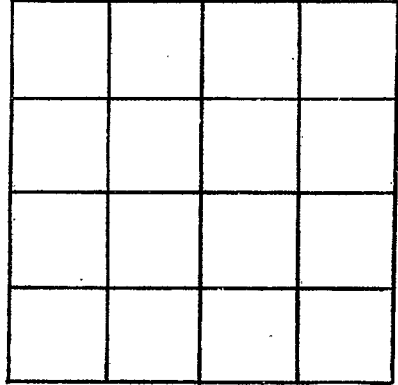

SECTION \_\_\_\_\_

Please indicate well location X.

ADDITIONAL INFORMATION

A series of horizontal lines providing space for additional information.

If more than one screen, show locations of each on sketch.