

Union
 F 2000
 5-25-79

MISSISSIPPI
 BOARD OF WATER COMMISSIONERS
 416 North State Street
 Jackson, Mississippi 39201

WATER WELL DRILLERS LOG

5-25 1979 J.W. Webb & Sons Union
 date well completed firm name county well located

LANDOWNER: Curtis Moody
macdonia

description of formations encountered	from	to
<u>Spil</u>	<u>0</u>	<u>1</u>
<u>Sand & Blue Sam</u>	<u>1</u>	<u>15</u>
<u>Soft Blue Rock</u>	<u>15</u>	<u>360</u>
<u>Rock</u>	<u>360</u>	<u>370</u>
<u>sand & Rocks</u>	<u>370</u>	<u>500</u>

(mailing address)

WELL LOCATION:
 sec. 8 T 7 N R 1 E
 (S) (W)

_____ miles _____ of _____
 (distance) (direction) (nearest town)

WELL PURPOSE:
 (home, irrigation, municipal, industrial)

WELL COMPLETION DATA:

- (1) diameter (inches) 4"
- (2) total depth (feet) 500
- (3) static water level (feet) 65' below above top of ground.
- (4) casing 10.5 _____
 (material) (depth)
 _____ if telescope see back.
 (size)
- (5) screen _____
 (length) (depth to top)

 (size) (material)
- (6) pump 1 1/2 6
 (HP) (yield gpm)
Edeco
 (type power)
- (7) electric log _____
 (yes or no)

 (organization running log)
- (8) how well bottom plugged open

DRILLERS REMARKS:


Miss. Board of Water Comm.

JUL 19 1979

RECEIVED

If well telescopes please sketch and show depths.

GROUND LEVEL

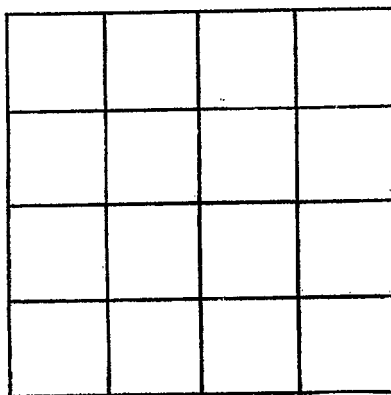

SECTION _____

Please indicate well location X.

ADDITIONAL INFORMATION

If more than one screen, show locations of each on sketch.