

UNION
F 2007
3/21/79

**MISSISSIPPI
BOARD OF WATER COMMISSIONERS**
416 North State Street
Jackson, Mississippi 39201

WATER WELL DRILLERS LOG

321 19 79 J T Madler UNION
 date well completed firm name county well located

LANDOWNER: Elmer Wooley
Enterprise, Etta R #
 (mailing address)

description of formations encountered	from	to
<u>Clay</u>	<u>0</u>	<u>360</u>
<u>rocky sand</u>	<u>360</u>	<u>400</u>

WELL LOCATION:
 sec 9 T 7 N R 1 E
4 miles N.W. of Enterprise
 (distance) (direction) (nearest town)

WELL PURPOSE:
 (home, irrigation, municipal, industrial)

- WELL COMPLETION DATA:
- (1) diameter (inches) 4
 - (2) total depth (feet) 400
 - (3) static water level (feet) 85 below above top of ground.
 - (4) casing P 140
 (material) (depth)
 (size) If telescope see back.
 - (5) screen _____
 (length) (depth to top)
 (size) (material)
 - (6) pump 5 10
 (HP) (yield gpm)
E
 (type power)
 - (7) electric log _____
 (yes or no)
 (organization running log)
 - (8) how well bottom plugged _____

DRILLERS REMARKS:


Miss. Board of Water Comm.

AUG 22 1979

RECEIVED

If well telescopes please sketch and show depths.

GROUND LEVEL

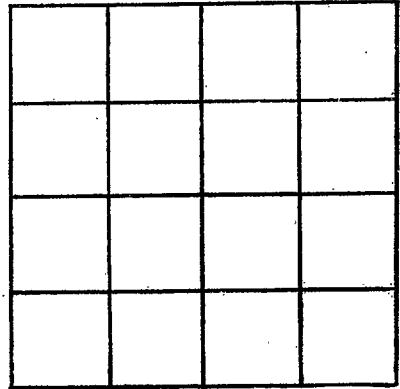

SECTION _____

Please indicate well location X.

ADDITIONAL INFORMATION

If more than one screen, show locations of each on sketch.