

| |
|---------|
| UNION |
| F 2008 |
| 4/12/79 |

**MISSISSIPPI
BOARD OF WATER COMMISSIONERS**
416 North State Street
Jackson, Mississippi 39201

WATER WELL DRILLERS LOG

4-12-1979 J.T. Madlin UNION
 date well completed firm name county well located

LANDOWNER: Dr. Henry
New Albany
Hwy 30 West
 (mailing address)

| description of formations encountered | from | to |
|---------------------------------------|------|-----|
| Clay | 0 | 410 |
| rock & sand | 410 | 480 |

WELL LOCATION:
 sec. 10 T. 7 N. R. 1 E.
Darden Lake
 (distance) (direction) (nearest town)

WELL PURPOSE:
 (home, irrigation, municipal, industrial)

WELL COMPLETION DATA:

(1) diameter (inches) 4

(2) total depth (feet) 480

(3) static water level (feet) 70 below top of ground.

(4) casing P 130
 (material) (depth)
 (size) if telescope see back.

(5) screen _____ (length) _____ (depth to top).
 (size) _____ (material) _____

(6) pump 1/2 12
 (HP) (yield gpm)
E
 (type power)

(7) electric log _____ (yes or no)
 _____ (organization running log)

(8) how well bottom plugged _____

DRILLERS REMARKS:


Miss. Board of Water Comm.

AUG 22 1979

RECEIVED

If well telescopes please sketch and show depths.

GROUND LEVEL

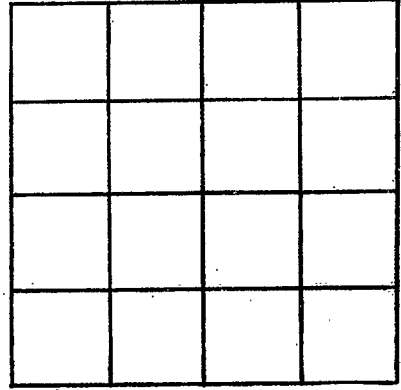

SECTION _____

Please indicate well location X.

ADDITIONAL INFORMATION

If more than one screen, show locations of each on sketch.