

Union

F 2009

7-11-80

MISSISSIPPI
 BOARD OF WATER COMMISSIONERS
 416 North State Street
 Jackson, Mississippi 39201

WATER WELL DRILLERS LOG

19 Medlin Water Well Cont

Union

date well completed July 11 1980 firm name _____ county well located _____

LANDOWNER: Ed. Potts
H.W. 30. West Enterprise
MS
 (mailing address)

description of formations encountered	from	to
	<u>Clay</u>	<u>0</u>
<u>sand</u>	<u>20</u>	<u>36</u>
<u>Clay</u>	<u>36</u>	<u>360</u>
<u>rock sand</u>	<u>360</u>	<u>390</u>

WELL LOCATION:
 sec. 15 T. 7 N. R. 1 E.
3 miles West of Enterprise
 (distance) (direction) (nearest town)

WELL PURPOSE:
 (home, irrigation, municipal, industrial)

- WELL COMPLETION DATA:
- (1) diameter (inches) 4
 - (2) total depth (feet) 390
 - (3) static water level (feet) 3 below/above top of ground.
 - (4) casing P 120
 (material) (depth)
 (size) if telescope see back.
 - (5) screen _____ (length) _____ (depth to top)
 (size) _____ (material) _____
 - (6) pump 3/4 18
 (HP) (yield gpm)
 (type power) E
 - (7) electric log _____ (yes or no)
 (organization running log) _____
 - (8) how well bottom plugged _____

DRILLERS REMARKS:


DEPT. OF NATURAL RESOURCES
 BUREAU OF LAND & WATER RESOURCES

JUL 21 1980

RECEIVED

If well telescopes please sketch and show depths.

GROUND LEVEL

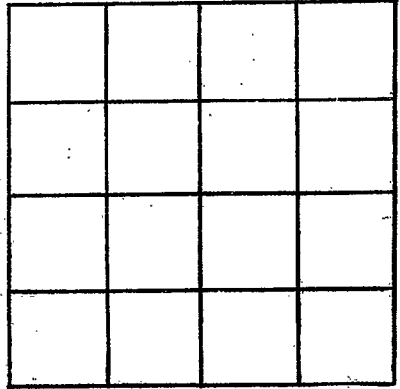

SECTION _____

Please indicate well location X.

ADDITIONAL INFORMATION

If more than one screen,
show locations of each on sketch.