

Union

F 2012

MISSISSIPPI DEPARTMENT OF NATURAL RESOURCES

Bureau of Land and Water Resources

Southport Mall.

P.O. Box 10631

Jackson, Mississippi 39209

WATER WELL DRILLERS LOG

3-19-1983 Mable Union
date well completed firm name county well located

LANDOWNER:

R. Potts
Myrtle MS
(mailing address)

description of formations encountered

from

to

top soil 0-140
clay

WELL LOCATION:

sec. 5 T. 7 N. R. 1 E. W. 5
5 miles SW of Myrtle
(distance) (direction) (nearest town)

clay - limestone 140-380

WELL PURPOSE:

(home, irrigation, municipal, industrial)

irrigation 380-480

WELL COMPLETION DATA:

- (1) diameter (inches) 4 1/2"
- (2) total depth (feet) 480
- (3) static water level (feet) 140 Below top of ground.
- (4) casing PVC 280 (material) (depth)

_____ if telescope see back.
(size)

- (5) screen _____ (length) _____ (depth to top)

(size) (material)

- (6) pump ETC 9 (HP) (yield gpm)
- (type power)

- (7) electric log _____ (yes or no)

_____ (organization running log)

- (8) how well bottom plugged _____

DRILLERS REMARKS:


DEPT. OF NATURAL RESOURCES
BUREAU OF LAND & WATER RESOURCES

MAY 5 - 1983

RECEIVED

If well telescopes please sketch and show depths.

GROUND LEVEL

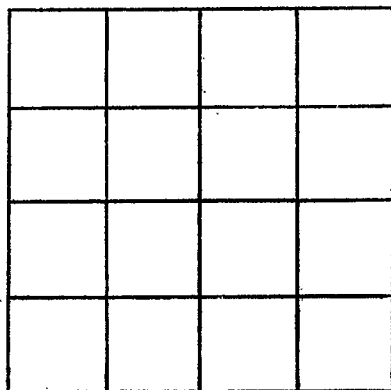

SECTION _____

Please indicate well location X.

ADDITIONAL INFORMATION

If more than one screen, show locations of each on sketch.