

MISSISSIPPI DEPARTMENT OF NATURAL RESOURCES

Bureau of Land and Water Resources

Southport Mall

P.O. Box 10631

Jackson, Mississippi 39209

WATER WELL DRILLERS LOG

F 2015
UNION
3-85

March 19 85 LEEDER Drilling UNION
 date well completed firm name county well located

LANDOWNER:	description of formations encountered	from	to
Dempsey FITTS			
West Union Community	TOP clay	0	30
New Albany, Ms -	Soft Blue clay	30	180
(mailing address)	Chalk	180	500
WELL LOCATION:			
sec. 10 T 7 N R 1 E			
3 1/2 miles N.W. of WEST UNION	SAND	500	545
(distance) (direction) (nearest town)			
WELL PURPOSE: HOME			
(home, irrigation, municipal, industrial)			
WELL COMPLETION DATA:			
(1) diameter (inches) 4			
(2) total depth (feet) 545			
(3) static water level (feet) 700 below top of ground			
(4) casing PVC 210 (material) (depth)			
4" (size) if telescope see back.			
(5) screen OPEN BOTTOM (length) (depth to top)			
(size) (material)			
(6) pump 1 10 (HP) (yield gpm)			
Electric and/or Nuclear (type power)			
(7) electric log NO (yes or no)			
(organization running log)			
(8) how well bottom plugged OPEN			


RECEIVED
 APR 1 8 1985

Department of Natural Resources
 Bureau of Land & Water Resources

DRILLERS REMARKS:

If well telescopes please sketch and show depths.

GROUND LEVEL

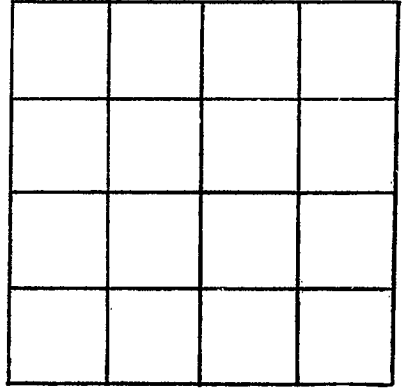

SECTION _____

Please indicate well location X.

ADDITIONAL INFORMATION

If more than one screen,
show locations of each on sketch.