

MISSISSIPPI DEPARTMENT OF NATURAL RESOURCES

Bureau of Land and Water Resources

Southport Mall

P.O. Box 10631

Jackson, Mississippi 39209

WATER WELL DRILLERS LOG

Union
F 2017

12.3 1987  
date well completed

Medlin Well  
firm name

Union  
county well located

LANDOWNER:  
Randy McDaniel  
Pinedale, Ms.  
(mailing address)

description of formations encountered	from	to
Top Soil - Sand	0	180
Rock - Sand -	180	200
Sand - Aquifer	200	260

WELL LOCATION:  
sec 34 T 7 N R 1 E  
3 miles North of Pinedale  
(distance) (direction) (nearest town)

WELL PURPOSE:  
(home irrigation, municipal, industrial)

- WELL COMPLETION DATA:
- (1) diameter (inches) 4"
  - (2) total depth (feet) 260'
  - (3) static water level (feet) 180 <sup>below</sup> top of ground
  - (4) casing PVC, 200' (material) (depth)  
    (size) if telescope see back.
  - (5) screen (length) (depth to top)  
    (size) (material)
  - (6) pump 3/4 (HP) 11 (yield gpm)  
    Electric (type power)
  - (7) electric log (yes or no)  
    (organization running log)
  - (8) how well bottom plugged


RECEIVED  
SEP 28 1989

Department of Natural Resources  
Bureau of Land & Water Resources

DRILLERS REMARKS:

If well telescopes please sketch and show depths.

GROUND LEVEL

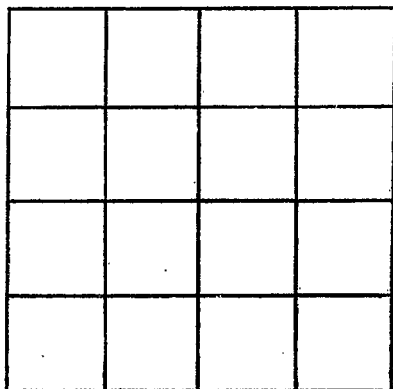

SECTION \_\_\_\_\_

Please indicate well location X.

ADDITIONAL INFORMATION

If more than one screen,  
show locations of each on sketch.