

MISSISSIPPI DEPARTMENT OF NATURAL RESOURCES

Bureau of Land and Water Resources

P.O. Box 10631

Jackson, Mississippi 39209

WATER WELL DRILLERS LOG

COUNTY WELL LOCATED UNION	
WELL NUMBER F 209	CODED
DATE WELL COMPLETED Sept 87	

PERMIT NUMBER
NAME OF DRILLING FIRM LEEPER Drilling
Pontotoc, MS

NAME & MAILING ADDRESS OF LANDOWNER Archie Maxey			
Rt 1			
Etta MS -			
WELL LOCATION: SEC	TOWNSHIP	RANGE	
9	7	1	S
DISTANCE	DIRECTION	NEAREST TOWN	
10 Miles	W	of New Albany	
OTHER LANDMARK			
WELL PURPOSE: Home, Irrigation, Municipal, Industrial, Fish Pond, etc. Home			

PUMP DATA		
PUMP TYPE (Circle One): <u>Submersible</u> , Turbine, Jet, Flowing Well, Other (Describe)		
POWER TYPE (Circle One): <u>Electric</u> , Tractor, Diesel, Gasoline, Butane, Other (Describe)		
Pump Capacity (GPM) 15	No. of Stages 10	Setting Depth 84 FT.
PUMP TEST		
Well yielded _____ GPM with a drawdown of _____ ft. after _____ hours of pumping		

WELL DATA		
Well Depth 460	Casing Diameter (In.) 4"	Casing Length (Ft.) 200'
Type of Casing PVC	Hole Depth 460	Depth to Static Water Level 4'
TYPE OF COMPLETION: (Circle One or More): Gravel Packed, Underreamed, Telescoped, Natural Development, <u>Open Hole</u> , Other (Describe)		
Top of Lap Pipe or Reduction in Casing FEET <input type="checkbox"/> IF TELESCOPED OR MORE THAN ONE SCREEN: USE BACK PAGE		

LOG DATA	
TYPE OF LOG RUN (Circle One): Electric, Gamma Ray, Density, Sonic, <u>No Log Run</u> , Neutron, Other (Describe)	
Name of Organization Running Log	

SCREEN DATA		
Diameter - Inches	Length - Feet	Slot Size - Inches
—	—	—
Screen Type	Depth to Bottom - Feet	
—	—	

GEOLOGIC DATA (Office Use Only)			
Surface Elev.	Geologic Unit	Unit Thickness	Depth to Top
Subs. SWL	Date	Analysis	Aquifer Test


Driller's Remarks

DESCRIPTION OF FORMATIONS ENCOUNTERED	FROM	TO	FORMATIONS (Continued)	FROM	TO
TOP CLAY	0	30	RECEIVED	DEC 10 1987	
BLUE CLAY	30	250			
CHALK	250	390			
SAND	390	460			

IF MORE SPACE IS NEEDED, USE BACK

If well telescopes please
sketch and show depths.

GROUND LEVEL

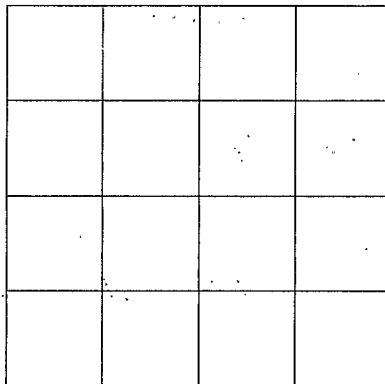

SECTION _____

Please indicate well location X.

ADDITIONAL INFORMATION

If more than one screen,
show location of each on sketch.