

WATER WELL DRILLERS LOG

CODING

No. 1960, Driller: Edmond Clark County: Union

TOLLISON

(Name)


(1) Owner of Land: James Tollison
 (Name)
 (Address)
 (2) Location: 1/4, 1/4, Sec. 11 75 28
4 miles W, of Marbleton
 (distance) (direction) (Nearest Town)
 (3) Topography: Hilly
 (Hilly) (Flat) (Level)
 (4) Purpose of Well: water
 (Domestic Irrigation
 Municipal, Industrial, Other)

Description & Color of Materials Sand, Clay, Red Clay, Shell, etc.	Thick- ness Feet	Depth Feet
<u>Red clay</u>	<u>30</u>	<u>30</u>
<u>Peeps Sand</u>	<u>45</u>	<u>75</u>
<u>Blue shale</u>	<u>180</u>	<u>255</u>

CODING

Information upon completion of well:

(1) Diameter 4 inches.
 (2) Total Depth 264 feet.
 (3) Water Level 45 feet below top of ground.
 (4) Cased to Blue shale, Size 80 ft case
 (5) Screen: Size more, Length _____
 (6) Were any formations sealed against pollution?
X yes, _____ no.
 If YES depth of formation 60
 Why copy Jordy liney

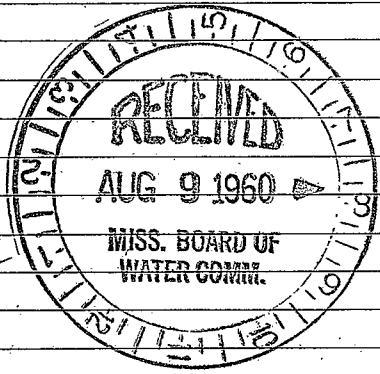

Drillers Remarks: _____

(Use Back Side)

Well No.

