

Union
G 11
12-22-69

MISSISSIPPI
BOARD OF WATER COMMISSIONERS
416 North State Street
Jackson, Mississippi 39201

CODED

WATER WELL DRILLERS LOG **CODED**

12-~~22~~ 1969 Clark Bros. Union
date well completed firm name county well located

LANDOWNER:
Kenny Adair
New Albany Rt 4
(mailing address)

description of formations encountered	from	to
<u>Shales</u>	0	15
<u>Rock & Sand</u>	15	50
<u>Blue mud</u>	50	180
<u>Rock & Sand</u>	180	265

WELL LOCATION:
sec. 32 T 8 N R 2 E
12 miles S-W of New Albany
(distance) (direction) (nearest town)

WELL PURPOSE: None
(home, irrigation, municipal, industrial)

WELL COMPLETION DATA:

(1) diameter (inches) 4"

(2) total depth (feet) 265'

(3) static water level (feet) 55' below above top of ground.

(4) casing Metal, 90',
(material) (depth)
4 if telescope see back.
(size)

(5) screen None
(length) (depth to top)
(size) (material)

(6) pump 1/2 Sub 3
(HP) (yield gpm)
Electric
(type power)

(7) electric log no
(yes or no)
(organization running log)

(8) how well bottom plugged no

CODED


JAN - 5 1970

MISSISSIPPI BOARD OF WATER COMMISSIONERS

DRILLERS REMARKS:

If well telescopes please sketch and show depths.

GROUND LEVEL

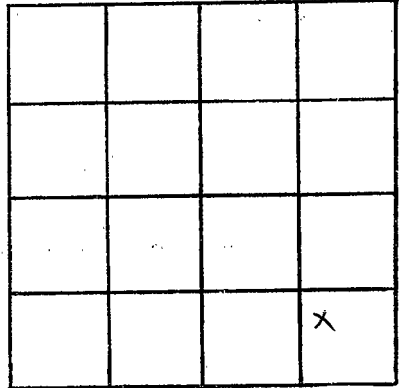

SECTION 32

Please indicate well location X.

ADDITIONAL INFORMATION

If more than one screen,
show locations of each on sketch.