

UNION
G 14
10-3-69

MISSISSIPPI
BOARD OF WATER COMMISSIONERS
416 North State Street
Jackson, Mississippi 39201

CODED

WATER WELL DRILLERS LOG

10-3-1969 date well completed
Jungweil Co. firm name
Union county well located

LANDOWNER:
Mose Knox
New Albany, Miss.
(mailing address)

description of formations encountered	from	to
Mixed Clay	0	50
Clay	50	150
Sand - Rock	150	240

WELL LOCATION:
sec 2 T 1 N R 2 E
S 1 S 1 E
2 miles New Albany
(distance) (direction) (nearest town)

WELL PURPOSE: Home
(home, irrigation, municipal, industrial)

- WELL COMPLETION DATA:
- (1) diameter (inches) 4"
 - (2) total depth (feet) 240
 - (3) static water level (feet) 40 below top of ground.
 - (4) casing PVC, 100 (material), (depth)
 - (5) screen (size) (length) (depth to top)
 - (6) pump 1/2 (HP), 8 (yield gpm)
Elec (type power)
 - (7) electric log (yes or no)
 - (8) how well bottom plugged

CODED


FEB 18 1970

MISS. Bd. of WATER COMMISSIONERS

DRILLERS REMARKS:

If well telescopes please sketch and show depths.

GROUND LEVEL

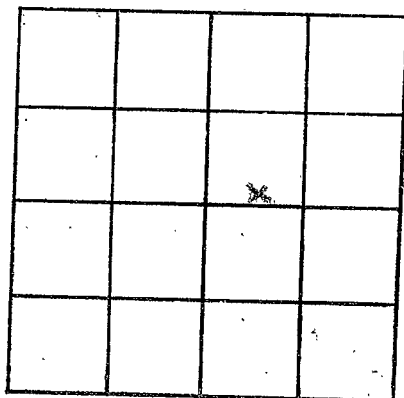

SECTION 2

Please indicate well location X.

ADDITIONAL INFORMATION

If more than one screen,
show locations of each on sketch.