

UNION
G 15
11-3-69

MISSISSIPPI
BOARD OF WATER COMMISSIONERS
416 North State Street
Jackson, Mississippi 39201

CODED

WATER WELL DRILLERS LOG

11-3-69 19
date well completed

Jumpwell Co - Union
firm name county well located

LANDOWNER:

Eddie Frazier
New Albany, Miss.
(mailing address)

description of formations encountered

from

to

<i>Mixed clay</i>	<i>0</i>	<i>50</i>
<i>Clay</i>	<i>50</i>	<i>150</i>
<i>Snd + Rock</i>	<i>150</i>	<i>240</i>

WELL LOCATION:

sec. *2* T. *7* S. R. *2* E
2 miles *NW* of *New Albany*
(distance) (direction) (nearest town)

WELL PURPOSE:

Home
(home, irrigation, municipal, industrial)

WELL COMPLETION DATA:

(1) diameter (inches) *4"*
(2) total depth (feet) *240*
(3) static water level (feet) *40* below top of ground.
(4) casing *PVC*, *100*,
(material) (depth)
(size) if telescope see back.

(5) screen *0* " *0*
(length) (depth to top)
0 " *0*
(size) (material)

(6) pump *1/2* " *8*
(HP) (yield gpm)
Elen
(type power)

(7) electric log *0*
(yes or no)
(organization running log)

(8) how well bottom plugged *0*

CODED


FEB 18 1970

MISS. BD. OF
WATER COMM.

DRILLERS REMARKS:

If well telescopes please sketch and show depths.

GROUND LEVEL

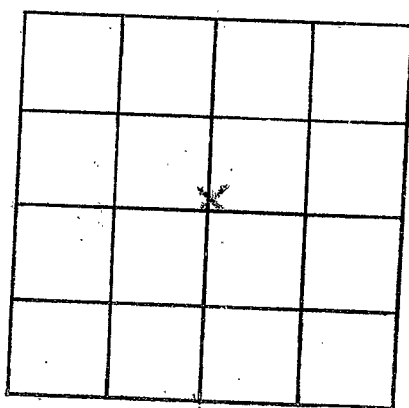

SECTION 2

Please indicate well location X.

ADDITIONAL INFORMATION

Lined area for additional information.

If more than one screen, show locations of each on sketch.