

RHA

COPIED

Union  
G 17  
2-20-70

MISSISSIPPI  
BOARD OF WATER COMMISSIONERS  
416 North State Street  
Jackson, Mississippi 39201

WATER WELL DRILLERS LOG

2-20 19 70 J.T. Mullin Union  
date well completed firm name county well located

LANDOWNER: Miss. Allam. State  
Miss  
(mailing address)

Description of formations encountered	from	to
clay	0	11
Black sand	11	16
Black	16	26
Black clay	26	33
Black	33	38
Blue clay	38	40
Black sand	40	50
Black clay	50	105
Black	105	125
Black	125	127
Black clay	127	135
Black	135	137

WELL LOCATION:  
sec. 7 T 7 N R. 2 E  
2 miles N of ingram  
(distance) (direction) (nearest town)

WELL PURPOSE:  
(home, irrigation, municipal, industrial)

WELL COMPLETION DATA:

- (1) diameter (inches) 4"
- (2) total depth (feet) 200
- (3) static water level (feet) 26 below above top of ground.
- (4) casing P 78  
(material) (depth)  
(size) if telescope see back.
- (5) screen \_\_\_\_\_  
(length) (depth to top)  
(size) (material)
- (6) pump 3/4 7  
(HP) (yield gpm)  
(type power)
- (7) electric log (yes or no) \_\_\_\_\_  
(organization running log)
- (8) how well bottom plugged \_\_\_\_\_

COPIED


MAR 4 1970

MISS. BD. OF  
WATER COMM.

DRILLERS REMARKS:

If well telescopes please sketch and show depths.

GROUND LEVEL

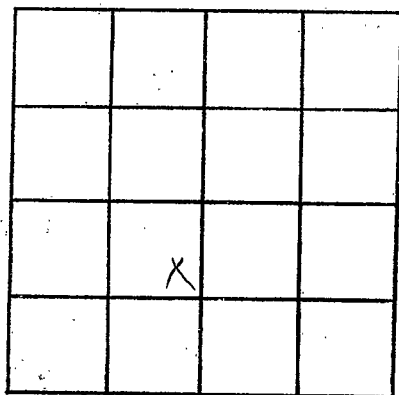

SECTION 36

Please indicate well location X.

ADDITIONAL INFORMATION

If more than one screen,  
show locations of each on sketch.