

Union
 G 19
 4-23-70

MISSISSIPPI
 BOARD OF WATER COMMISSIONERS
 416 North State Street
 Jackson, Mississippi 39201

CODED

WATER WELL DRILLERS LOG

4-23 1970 Clark Bros. Union
 date well completed firm name county well located

LANDOWNER:
T. N. Jordan
Rents one, Myrtle
 (mailing address)
 WELL LOCATION:
 sec. 17 T. 7 N. R. 2 170
7 miles W of New Albany
 (distance) (direction) (nearest town)

description of formations encountered	from	to
<u>Shale</u>	<u>0</u>	<u>20</u>
<u>Rock & Sand</u>	<u>20</u>	<u>40</u>
<u>Blue Mud</u>	<u>40</u>	<u>200</u>
<u>Rock & Sand</u>	<u>200</u>	<u>230</u>
<u>Blue mud</u>	<u>230</u>	<u>280</u>
<u>Rock & Sand</u>	<u>280</u>	<u>330</u>

WELL PURPOSE: Water
 (home, irrigation, municipal, industrial)

- WELL COMPLETION DATA:
- (1) diameter (inches) 4"
 - (2) total depth (feet) 330'
 - (3) static water level (feet) 50' below top of ground.
 - (4) casing metal 82'
 (material) (depth)
4" if telescope see back.
 (size)
 - (5) screen none
 (length) (depth to top)
 (size) (material)
 - (6) pump 1 gal 7
 (HP) (yield gpm)
Electric
 (type power)
 - (7) electric log no
 (yes or no)
 (organization running log)
 - (8) how well bottom plugged no


CODED

MAY 14 1970
 MISS. Bd. of WATER COM.

DRILLERS REMARKS:

If well telescopes please sketch and show depths.

GROUND LEVEL

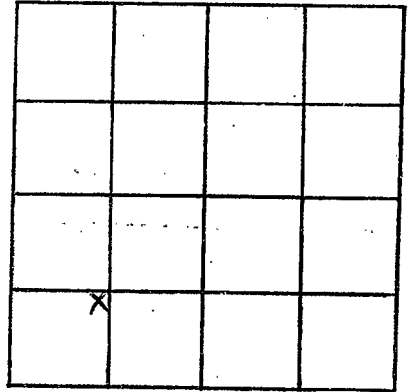

SECTION _____

Please indicate well location X.

ADDITIONAL INFORMATION

If more than one screen, show locations of each on sketch.