

Union
G 20
5-7-70

MISSISSIPPI
BOARD OF WATER COMMISSIONERS
416 North State Street
Jackson, Mississippi 39201

CODED

WATER WELL DRILLERS LOG

5-7 19 70 date well completed
J.T. McCallin firm name
W.M.P.A. county well located

LANDOWNER: Robert W. Borders
New Albany
(mailing address) 216

description of formations encountered	from	to
White limestone	0	9
Blue clay	9	20
Blue clay	20	97
Blue clay	97	139
Blue clay	139	154
Blue clay	154	191
Blue clay	191	197
Blue clay	197	201
Blue clay	201	221
Blue clay	221	253
Blue clay	253	267
Blue clay	267	287
Blue clay	287	287

WELL LOCATION:
sec. 10 T. 7 N. R. 2 E
4 miles West of New Albany
(distance) (direction) (nearest town)

WELL PURPOSE:
(home, irrigation, municipal, industrial)

WELL COMPLETION DATA: 5170

- (1) diameter (inches) 4
- (2) total depth (feet) 287
- (3) static water level (feet) 60 below top of ground.
- (4) casing P 165 (material) (depth)
- (size) if telescope see back.
- (5) screen (length) (depth to top)
- (size) (material)
- (6) pump 3/4 R (HP) (yield gpm)
- E (type power)
- (7) electric log (yes or no)
- (organization running log)
- (8) how well bottom plugged

CODED


JUN 3 1970

DRILLERS REMARKS:

MISS. Bd. OF
WATER COMM.

If well telescopes please sketch and show depths.

GROUND LEVEL

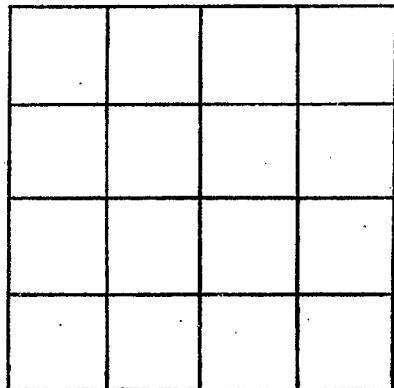

SECTION _____

Please indicate well location X.

ADDITIONAL INFORMATION

If more than one screen, show locations of each on sketch.