

MISSISSIPPI
BOARD OF WATER COMMISSIONERS
416 North State Street
Jackson, Mississippi 39201

CODED

WATER WELL DRILLERS LOG

UNION
G23
8-21-70

Aug 21 1970 Clark Bros Union
date well completed firm name county well located

LANDOWNER: Joe Roberts
description of formations encountered from to
Route 4, New Albany Rock & Sand 0 20
(mailing address) Blue mud 20 80
Rock & Sand 80 180
180 286

WELL LOCATION:
sec. 23 T 7 N R 2 E 170
5 miles SW of New Albany
(distance) (direction) (nearest town)

WELL PURPOSE: none
(home, irrigation, municipal, industrial)


WELL COMPLETION DATA:
(1) diameter (inches) 4"
(2) total depth (feet) 286'
(3) static water level (feet) 39' below above top of ground.
(4) casing Metal 105' (material) (depth)
4" (size) if telescope see back.
(5) screen none (length) (depth to top)
(size) (material)
(6) pump 3/4 Sub 9 (HP) (yield gpm)
Electric (type power)
(7) electric log no (yes or no)
(organization running log)
(8) how well bottom plugged no

CODED

DRILLERS REMARKS:
SEP 2 1970
MISS. RD. OF WATER COMM.

If well telescopes please sketch and show depths.

GROUND LEVEL

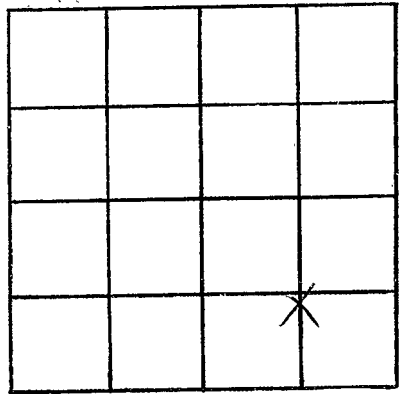

SECTION _____

Please indicate well location X.

ADDITIONAL INFORMATION

Lined area for additional information.

If more than one screen, show locations of each on sketch.