

MISSISSIPPI
 BOARD OF WATER COMMISSIONERS
 416 North State Street
 Jackson, Mississippi 39201

CODED

WATER WELL DRILLERS LOG

Union
 G 25
 7-17-70

7 17 1970 date well completed
 J T Madlin firm name
 Union county well located

LANDOWNER: A W Jagon

description of formations encountered	from	to
White Clay	0	4
Sandstone	4	20
Blue "	20	43
Rock	43	64
Black Clay	64	69
Rock	69	86
Black Clay	86	148
Rock	148	154
Sand	154	184
Rock	184	188
Blue "	188	198
Sand	198	238
Blue "	238	243
Sand	243	256
Blue "	256	278
Sand	278	282
Blue "	282	300

R# 4
New Albany
 (mailing address)

WELL LOCATION:

sec. 11 T. 7 N. R. 2 E
3 miles West of New Albany
 (distance) (direction) (nearest town)

WELL PURPOSE:
 (home, irrigation, municipal, industrial)

WELL COMPLETION DATA:

- (1) diameter (inches) 4
- (2) total depth (feet) 300
- (3) static water level (feet) 24 below above top of ground:
- (4) casing Black 106
 (material) (depth)

 if telescope see back.
 (size)

- (5) screen
 (length) (depth to top)

 (size) (material)

- (6) pump 5 6
 (HP) (yield gpm)

6
 (type power)

- (7) electric log
 (yes or no)

 (organization running log)

- (8) how well bottom plugged Block

DRILLERS REMARKS:


CODED

AUG - 3 1970

MSGS. BD. 75
 WATER C

If well telescopes please
sketch and show depths.

GROUND LEVEL

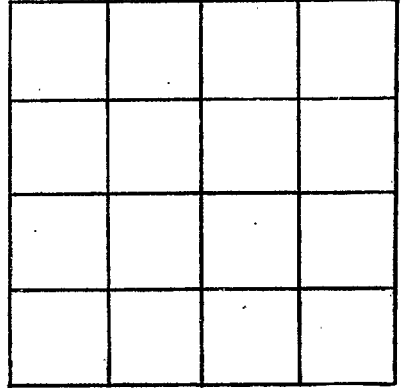

SECTION _____

Please indicate well location X.

ADDITIONAL INFORMATION

If more than one screen,
show locations of each on sketch.