

Union
G-27
6-16-70

MISSISSIPPI
BOARD OF WATER COMMISSIONERS
416 North State Street
Jackson, Mississippi 39201

CODED

WATER WELL DRILLERS LOG

6-16 1970 Clark Bros. Union
date well completed firm name county well located

LANDOWNER:
Harmony Baptist Church
Route 9, New Albany
(mailing address)

description of formations encountered	from	to
Lumbo	0	25
Rock	25	45
Blue Mud	45	85
Rock	85	110
Blue mud	110	220
Rock & Sand	220	264

WELL LOCATION:
sec. 8 T 7 N R 2 E
6 miles W of New Albany
(distance) (direction) (nearest town)

WELL PURPOSE: Church
(home, irrigation, municipal, industrial)

WELL COMPLETION DATA:

(1) diameter (inches) 4"

(2) total depth (feet) 264'

(3) static water level (feet) 65' below top of ground.

(4) casing Metal, 84' (material) (depth)
4" (size) if telescope see back.

(5) screen None (length) (depth to top)
(size) (material)

(6) pump 1 1/2 HP 6 (type power) (yield gpm)
Electric (type power)

(7) electric log no (yes or no)
(organization running log)

(8) how well bottom plugged no

CODED


JUL 1 1970

DRILLERS REMARKS:

MISS. BD. OF
WATER COMM.

If well telescopes please sketch and show depths.

GROUND LEVEL

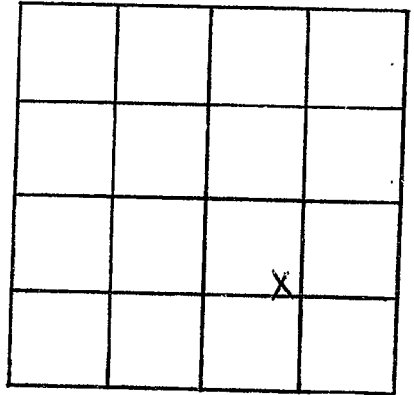

SECTION _____

Please indicate well location X.

ADDITIONAL INFORMATION

If more than one screen, show locations of each on sketch.