

UNION
G28
7-9-70

MISSISSIPPI
BOARD OF WATER COMMISSIONERS
416 North State Street
Jackson, Mississippi 39201

CODED

WATER WELL DRILLERS LOG

July 9 1970 Clark Bros Union
(date well completed) firm name county well located

LANDOWNER:
Ortis Allen
Rt. 4, New Albany
(mailing address)

description of formations encountered	from	to
<u>Shaly</u>	<u>0</u>	<u>20</u>
<u>Sand</u>	<u>20</u>	<u>60</u>
<u>Blue mud</u>	<u>60</u>	<u>200</u>
<u>Rock & sand</u>	<u>200</u>	<u>250</u>
<u>Blue mud</u>	<u>250</u>	<u>290</u>
<u>Rock & Sand</u>	<u>290</u>	<u>350</u>

WELL LOCATION:
sec. 25 T 7 N R. 2 E
10 miles S-W of New Albany
(distance) (direction) (nearest town)

WELL PURPOSE: Home
(home, irrigation, municipal, industrial)

- WELL COMPLETION DATA:
- (1) diameter (inches) 4"
 - (2) total depth (feet) 350'
 - (3) static water level (feet) 60' below above top of ground.
 - (4) casing metal, 100'
(material) (depth)
4" if telescope see back.
(size)
 - (5) screen none
(length) (depth to top)
(size) (material)
 - (6) pump 1 set 6
(HP) (yield gpm)
Electric
(type power)
 - (7) electric log no
(yes or no)
(organization running log)
 - (8) how well bottom plugged no

CODED


AUG 6 1970

MISS. BD. OF
WATER COMMISSIONERS

DRILLERS REMARKS:

If well telescopes please sketch and show depths.

GROUND LEVEL

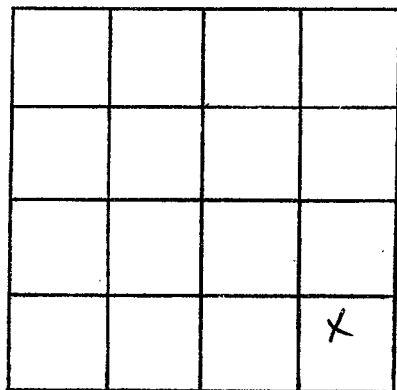

SECTION _____

Please indicate well location X.

ADDITIONAL INFORMATION

If more than one screen, show locations of each on sketch.