

UNION
G 29
7-24-70

MISSISSIPPI
BOARD OF WATER COMMISSIONERS
416 North State Street
Jackson, Mississippi 39201

CODED

WATER WELL DRILLERS LOG

Union

724 1970
date well completed

J. T. Medlin
firm name

~~Union~~
county well located

LANDOWNER: Chalmers
Porter Box 18 B
R # 4 New Albany
(mailing address)

description of formations encountered

from to

Clay	0	14
Rock	14	26
Sand	26	32
Blue Clay	32	148
Sand	148	152
Rock	152	156
Sand	156	180

WELL LOCATION:

sec. 13 T 7 N R 2 E
4 miles S.W. of New Albany
(distance) (direction) (nearest town)

WELL PURPOSE:

(home, irrigation, municipal, industrial)

WELL COMPLETION DATA:

- (1) diameter (inches) 4
- (2) total depth (feet) 180
- (3) static water level (feet) 16 below top of ground.
- (4) casing P 68
(material) (depth)
(size) if telescope see back.
- (5) screen 2 8
(length) (depth to top)
(size) (material)
- (6) pump 1/2 8
(HP) (yield gpm)
C
(type power)
- (7) electric log
(yes or no)
(organization running log)
- (8) how well bottom plugged Clay

CODED


AUG 18 1970

DRILLERS REMARKS:

MISS. BD. OF
WATER COMM.

If well telescopes please sketch and show depths.

GROUND LEVEL

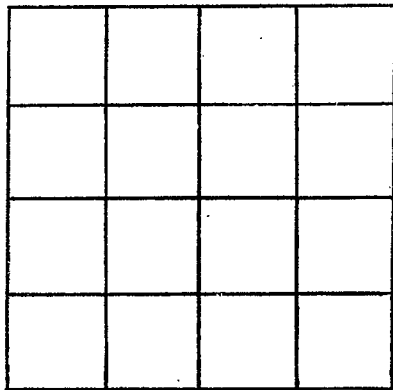

SECTION _____

Please indicate well location X.

ADDITIONAL INFORMATION

If more than one screen,
show locations of each on sketch.