

10

Union Co
G 30
7-69

MISSISSIPPI
BOARD OF WATER COMMISSIONERS
416 North State Street
Jackson, Mississippi 39201

CODED
CODED

WATER WELL DRILLERS LOG

7-26 1969 date well completed
Clark Bros firm name
Union county well located

LANDOWNER:
W. H. Kammorn
Route 2 New Albany
(mailing address)

description of formations encountered	from	to
shales	0	15
Rock of Sand	15	55
Blue Marl	55	255
Rock of Sand	255	264

WELL LOCATION:
sec. 8 T40N R2E
6 miles W of New Albany
(distance) (direction) (nearest town)

WELL PURPOSE: Home
(home, irrigation, municipal, industrial)

- WELL COMPLETION DATA:
- (1) diameter (inches) 4
 - (2) total depth (feet) 264
 - (3) static water level (feet) 40 below top of ground.
 - (4) casing Metal 84 (material) (depth)
4 (size) if telescope see back.
 - (5) screen none (length) (depth to top)
(size) (material)
 - (6) pump 1 1/2 (HP) 6 (yield gpm)
Electric (type power)
 - (7) electric log NO (yes or no)
(organization running log)
 - (8) how well bottom plugged NO

CODED


AUG 7 1969

MISS. Bd. of
Water Comm.

DRILLERS REMARKS:

If well telescopes please sketch and show depths.

GROUND LEVEL

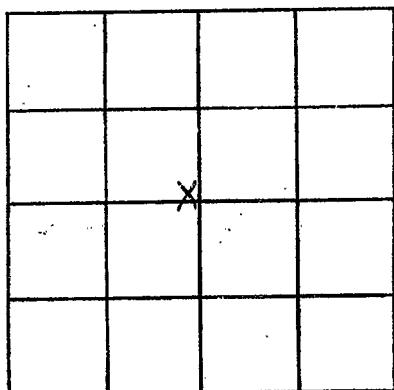

SECTION _____

Please indicate well location X.

ADDITIONAL INFORMATION

If more than one screen,
show locations of each on sketch.