

UNION
G 32
4-17-71

MISSISSIPPI
BOARD OF WATER COMMISSIONERS
416 North State Street
Jackson, Mississippi 39201

CODED

WATER WELL DRILLERS LOG

4 17 19 71 J T Medlin Union
date well completed firm name county well located

LANDOWNER James Garrison
R# 4 New Albany
(mailing address)

| description of formations encountered | from | to |
|---------------------------------------|------------|------------|
| <u>W. Clay</u> | <u>0</u> | <u>23</u> |
| <u>B "</u> | <u>23</u> | <u>260</u> |
| <u>sand</u> | <u>260</u> | <u>268</u> |
| <u>Rock</u> | <u>268</u> | <u>275</u> |
| <u>sand</u> | <u>275</u> | <u>304</u> |
| <u>Blue clay</u> | <u>304</u> | <u>320</u> |

WELL LOCATION:
sec 7 T 7 N R 2 E
6 miles W of New Albany
(distance) (direction) (nearest town)

WELL PURPOSE:
(home, irrigation, municipal, industrial)

- WELL COMPLETION DATA:
- (1) diameter (inches) 4
 - (2) total depth (feet) 320
 - (3) static water level (feet) 65 below above top of ground.
 - (4) casing P 120,
(material) (depth)
(size) If telescope see back.
 - (5) screen _____
(length) (depth to top)
(size) (material)
 - (6) pump 3/4 5
(HP) (yield gpm)
E
(type power)
 - (7) electric log _____
(yes or no)
(organization running log)
 - (8) how well bottom plugged BW

CODED


MAY 4 - 1971

MISS. BD. OF
WATER COMM.

DRILLERS REMARKS:

If well telescopes please sketch and show depths.

GROUND LEVEL

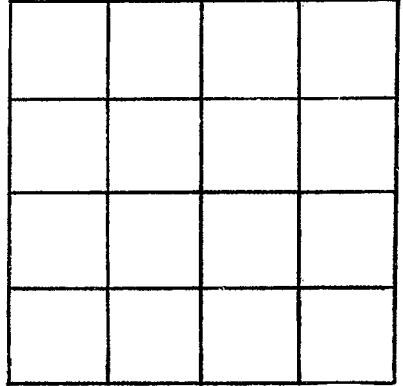

SECTION _____

Please indicate well location X.

ADDITIONAL INFORMATION

If more than one screen,
show locations of each on sketch.