

UNION
G-36
8-26-71

MISSISSIPPI
BOARD OF WATER COMMISSIONERS
416 North State Street
Jackson, Mississippi 39201

CODED

WATER WELL DRILLERS LOG

8-26 1971 Clair Bros Union
date well completed firm name county well located

LANDOWNER:
A.E. Coates
RT 4, New Albany
(mailing address)

description of formations encountered	from	to
<u>Shales</u>	<u>0</u>	<u>35</u>
<u>Rock & Sand</u>	<u>35</u>	<u>60</u>
<u>Blue Mud</u>	<u>60</u>	<u>180</u>
<u>Rock & Sand</u>	<u>180</u>	<u>220</u>

WELL LOCATION:
sec. 33 T 7 N R. 2 E
8 miles SW of New Albany
(distance) (direction) (nearest town)

WELL PURPOSE: Home
(home, irrigation, municipal, industrial)

- WELL COMPLETION DATA:
- (1) diameter (inches) 4"
 - (2) total depth (feet) 220'
 - (3) static water level (feet) 30' below top of ground.
 - (4) casing Metals, 78'
(material) (depth)
4"
(size) if telescope see back.
 - (5) screen None
(length) (depth to top)
(size) (material)
 - (6) pump 1 jet 7
(HP) (yield gpm)
Electric
(type power)
 - (7) electric log no
(yes or no)
(organization running log)
 - (8) how well bottom plugged 120

CODED


SEP 13 1971

MISS. Bd. of
Water Comm.

DRILLERS REMARKS:

If well telescopes please sketch and show depths.

GROUND LEVEL

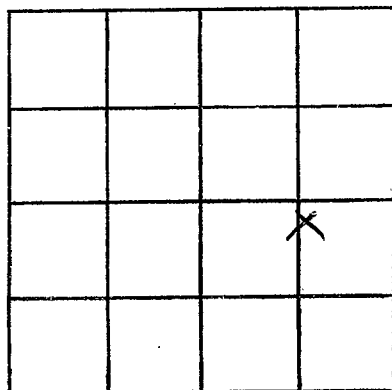

SECTION _____

Please indicate well location X.

ADDITIONAL INFORMATION

If more than one screen,
show locations of each on sketch.