

UNION MISSISSIPPI BOARD OF WATER COMMISSIONERS

G40
4-12-62

WATER WELL DRILLERS LOG

CODED

60
24
34

Date: 4-12, 19 42 Driller: C F CARLISE County UNION
(Name)

(1) Owner of Land: ARLESTER TURNER
(Name)
NEW ALBANY
(Address)

(2) Location: 1/4, NW 1/4, Sec. 13 T. 7R2,
3 miles SW, of IVA
(distance) (direction) (Nearest Town)

(3) Topography: X
(Hilly) (Flat) (Level)

(4) Purpose of Well:
(Domestic Irrigation
Municipal, Industrial, Other)

Description & Color of Materials (Sand, Clay, Red Clay, Shell, etc.)	Thick- ness Feet.	Depth Feet
RED CLAY	20	20
ROCK	26	46
LIME ROCK	83	130
WATER ROCK	4	134
" "	34	170

Information upon completion of well:

(1) Diameter 4 inches.

(2) Total Depth 170 feet.

(3) Water Level 20 feet below top of ground.

(4) Cased to 84, Size _____

(5) Screen: Size _____, Length _____


(6) Were any formations sealed against pollution?
_____ yes, _____ no.

If YES depth of formation _____

Why _____

Drillers Remarks: _____

CODED

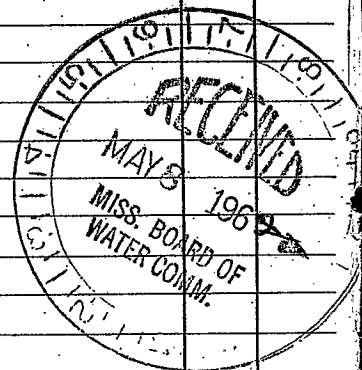

24
Well No.

(Use Back Side)

1. The first part of the document discusses the importance of maintaining accurate records of all transactions. It emphasizes that this is essential for the proper management of the organization's finances and for ensuring compliance with applicable laws and regulations.

2. The second part of the document outlines the specific procedures that should be followed when recording transactions. This includes the use of standardized forms and the requirement that all entries be supported by appropriate documentation, such as invoices and receipts.

3. The third part of the document addresses the issue of internal controls. It stresses that a robust system of internal controls is necessary to prevent errors and fraud, and to ensure the integrity of the financial reporting process.

4. The fourth part of the document discusses the role of the accounting department in providing timely and accurate financial information to management. It highlights the importance of regular communication and reporting to support informed decision-making.

5. The fifth part of the document concludes by reiterating the commitment to transparency and accountability in all financial activities. It expresses confidence that the implemented measures will ensure the highest standards of financial management.