

UNION MISSISSIPPI BOARD OF WATER COMMISSIONERS

G41  
5-16-62

WATER WELL DRILLERS LOG

**CODED**

Date: 5-14, 1962 Driller: C F CHARLTON County: UNION  
(Name)

	Description & Color of Materials (Sand, Clay, Red Clay, Shell, etc.)	Thick- ness Feet	Depth Feet
(1) Owner of Land: <u>MARVIN WILLARD</u> (Name) <u>NEW ALBANY MISS</u> (Address)	<u>SOAP STONE</u>	<u>23</u>	<u>23</u>
(2) Location: <u>1/4</u> , <u>1/4</u> , Sec <u>7-72</u> <u>4</u> miles <u>WEST</u> of <u>IVA</u> (distance) (direction) (Nearest Town)	<u>BLUE DIRT</u>	<u>40</u>	<u>43</u>
(3) Topography: <u>X</u> (Hilly) (Flat) (Level)	<u>ROCK &amp; sand</u>	<u>35</u>	<u>100</u>
(4) Purpose of Well: <u>DOMESTIC</u> (Domestic Irrigation Municipal, Industrial, Other)	<u>BLUE DIRT</u>	<u>40</u>	<u>140</u>
	<u>ROCK</u>	<u>10</u>	<u>150</u>
	<u>W-SAND</u>	<u>40</u>	<u>190</u>


Information upon completion of well:

- (1) Diameter 4 inches.
- (2) Total Depth 190 feet.
- (3) Water Level 40 feet below top of ground.
- (4) Cased to 129, Size 4 in.
- (5) Screen: Size \_\_\_\_\_, Length \_\_\_\_\_.
- (6) Were any formations sealed against pollution?  
\_\_\_\_\_ yes, \_\_\_\_\_ no.

If YES depth of formation \_\_\_\_\_  
Why \_\_\_\_\_

Drillers Remarks: \_\_\_\_\_

**CODED**

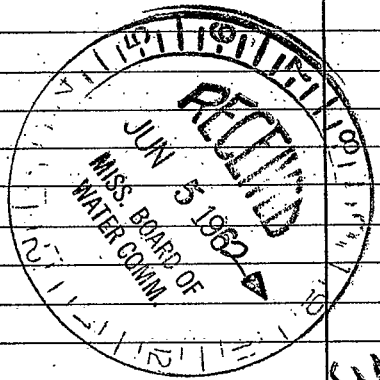

30

Well No.

(Use Back Side)

Faint, illegible text at the top of the page, possibly a header or introductory paragraph.

... ..  
... ..  
