

Union
G 43

MISSISSIPPI BOARD OF WATER COMMISSIONERS

9-66

WATER WELL DRILLERS LOG

CODED
NON

Date: 9 28, 1966, Driller: C F CARLISLE County: NON
(Name)

(1) Owner of Land: DR GUS PARR
(Name)

NEW ALBANY MISSRI
(Address)

(2) Location: NE 1/4, NW 1/4, Sec. 12 T33 R25 E

3/4 miles W of VA
(distance) (direction) (Nearest Town)

(3) Topography: X
(Hilly) (Flat) (Level)

(4) Purpose of Well: DOMESTIC
(Domestic Irrigation
Municipal, Industrial, Other)

Description & Color of Materials
Sand, Clay, Red Clay, Shell, etc.

Thick-
ness
Feet

Depth
Feet

<u>RED CLAY</u>	<u>26</u>	<u>26</u>
<u>ROCK</u>	<u>40</u>	<u>46</u>
<u>BLUE DIRT</u>	<u>10</u>	<u>124</u>
<u>ROCK</u>	<u>4</u>	<u>130</u>
<u>W SAND</u>	<u>42</u>	<u>172</u>

Information upon completion of well:

(1) Diameter 4 inches.

(2) Total Depth 172 feet.

(3) Water Level 49 feet below top of ground.

(4) Cased to 84, Size 4 in

(5) Screen: Size NONE Length _____


(6) Were any formations sealed against pollution?
_____ yes, X no.

If YES depth of formation _____

Why _____

Drillers Remarks: _____

CODED

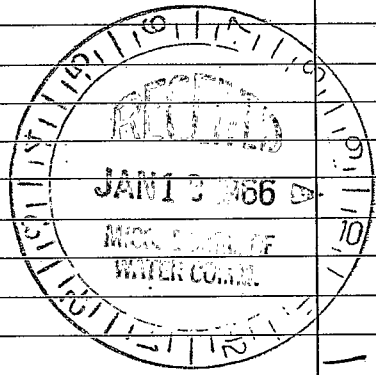

Well No. 115

(Use Back Side)

