

123

MISSISSIPPI
BOARD OF WATER COMMISSIONERS
416 North State Street
Jackson, Mississippi 39201

CODED

WATER WELL DRILLERS LOG

UNION
G45
10/67

10-15
date well completed

19 767 barlike
firm name

UNION
county well located

LANDOWNER:

GB ADIAR
NEWALBAHW R3.
(mailing address)

description of formations encountered

from to

WHITE DIRT	0	30
ROCK & SOFT ROCK	30	6.5
BLUE DIRT	6.5	130
WATER ROCK	130	138
II SAND	138	170

WELL LOCATION:

sec. 16 T 7 S R 2 E
4 miles W of NeA.
(distance) (direction) (nearest town)

WELL PURPOSE: HOME
(home, irrigation, municipal, industrial)

WELL COMPLETION DATA:

- (1) diameter (inches) 4
- (2) total depth (feet) 170
- (3) static water level (feet) 30 below top of ground.
- (4) casing STEEL (8 1/2)
(material) (depth)

CODED

 if telescope see back.
(size)

- (5) screen ()
(length) (depth to top)

 (size) (material)

- (6) pump 1/2 ()
(HP) (yield gpm)


(type power)

- (7) electric log NO
(yes or no)

(organization running log)


- (8) how well bottom plugged

DRILLERS REMARKS:

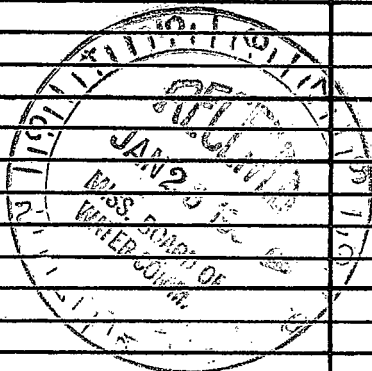

If well telescopes please sketch and show depths.

GROUND LEVEL

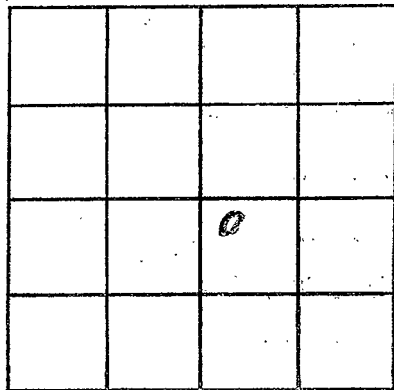

SECTION _____

Please indicate well location X.

ADDITIONAL INFORMATION

If more than one screen, show locations of each on sketch.