

UNION  
 646  
 4-68

MISSISSIPPI 1 1958  
 BOARD OF WATER COMMISSIONERS  
 416 North State Street  
 Jackson, Mississippi 39201  
 MISSISSIPPI WATER CO.

WATER WELL DRILLERS LOG

**CODED**

4-23 1968 Clark Bros. Union  
 date well completed firm name county well located

LANDOWNER: James H. Sater

RT 7, New Albany

(mailing address)

WELL LOCATION:

sec. 1 T. 7 N R. 2 E  
 2 miles W of New Albany  
 (distance) (direction) (nearest town)

WELL PURPOSE: Home  
 (home, irrigation, municipal, industrial)

WELL COMPLETION DATA:

- (1) diameter (inches) 4 in
- (2) total depth (feet) 200
- (3) static water level (feet) 45' below top of ground.
- (4) casing metal, 90, (material) (depth)  
 4 (size) if telescope see back.
- (5) screen None (length) (depth to top)  
 (size) (material)
- (6) pump 1/2 Sub. 8 (HP) (yield gpm)  
 Electric (type power)
- (7) electric log No (yes or no)  
 (organization running log)
- (8) how well bottom plugged No

description of formations encountered

from to


Sumho	0	20
Rock & Sand	20	80
Blue mud	80	120
Rock	120	130
Blue mud	130	150
Rock & Sand	150	200

**CODED**

DRILLERS REMARKS:

If well telescopes please sketch and show depths.

GROUND LEVEL

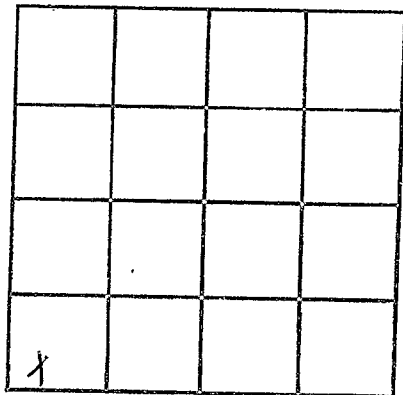

SECTION \_\_\_\_\_

Please indicate well location X.

ADDITIONAL INFORMATION

If more than one screen,  
show locations of each on sketch.