

Union
G-47
6-68

MISSISSIPPI
BOARD OF WATER COMMISSIONERS
416 North State Street
Jackson, Mississippi 39201

CODED

WATER WELL DRILLERS LOG

6-13 1968 Clark Bros. Union
date well completed firm name county well located

LANDOWNER: Boyce Mayo

description of formations encountered from to

Route
New Albany
(mailing address)

Sumo	0	20
Rock & Sand	20	80
Blue mud	80	160
Rock & Sand	160	200

WELL LOCATION:
sec 24 T-7 N R-2 E
4 miles SW of New Albany
(distance) (direction) (nearest town)

WELL PURPOSE: Home
(home, irrigation, municipal, industrial)

WELL COMPLETION DATA:

- (1) diameter (inches) 4"
- (2) total depth (feet) 200
- (3) static water level (feet) 35' below top of ground.
- (4) casing Metal 88'
(material) (depth)
4" (size) if telescope see back.
- (5) screen None
(length) (depth to top)
(size) (material)
- (6) pump 1/2 Sub. 14
(HP) (yield gpm)
Electric
(type power)
- (7) electric log No
(yes or no)
(organization running log)
- (8) how well bottom plugged No


CODED

JUN 23 1968
MISS. BOARD OF
WATER COMMISSIONERS

DRILLERS REMARKS:

If well telescopes please sketch and show depths.

GROUND LEVEL

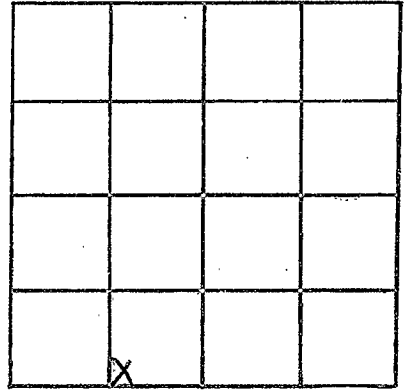

SECTION _____

Please indicate well location X.

ADDITIONAL INFORMATION

If more than one screen, show locations of each on sketch.