

Union  
 G 49  
 7-6-68

MISSISSIPPI  
 BOARD OF WATER COMMISSIONERS  
 416 North State Street  
 Jackson, Mississippi 39201

WATER WELL DRILLERS LOG **CODED**

7-6 1968 Ed Clark Con. Union  
 date well completed firm name county well located

LANDOWNER:

Lee Russell Howell  
 New Albany Rt. 4  
 (mailing address)

WELL LOCATION:

sec 23 T 7 N R 2 E  
 4 miles S-W of New Albany  
 (distance) (direction) (nearest town)

WELL PURPOSE:


Home  
 (home, irrigation, municipal, industrial)

WELL COMPLETION DATA:

- (1) diameter (inches) 4"
- (2) total depth (feet) 200'
- (3) static water level (feet) 8' below top of ground.
- (4) casing Metal, 70' (material) (depth)  
 4" (size) if telescope see back.
- (5) screen None (length) (depth to top)  
 (size) (material)
- (6) pump 5/8 jet 5 (HP) (yield gpm)  
 Electric (type power)
- (7) electric log no (yes or no)  
 (organization running log)
- (8) how well bottom plugged no

description of formations encountered	from	to
Clay	0	15
Rock & Sand	15	70
Blue mud	70	100
Rock & Sand	100	140
Blue mud	140	160
Rock & Sand	160	200


**CODED**

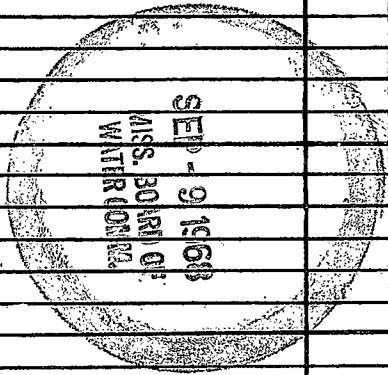

DRILLERS REMARKS:

If well telescopes please sketch and show depths.

GROUND LEVEL

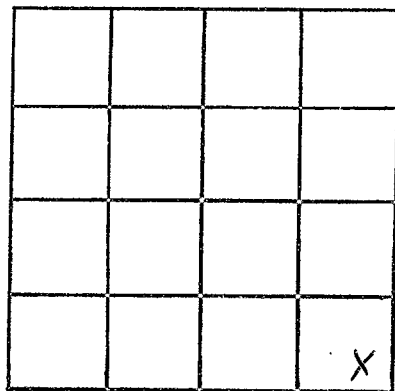

SECTION \_\_\_\_\_

Please indicate well location X.

ADDITIONAL INFORMATION

If more than one screen,  
show locations of each on sketch.