

**MISSISSIPPI
BOARD OF WATER COMMISSIONERS**
416 North State Street
Jackson, Mississippi 39201

WATER WELL DRILLERS LOG **CODED**

Union
G 50
8-15-68

8-15 1968 Ed Clark Con. Union
date well completed firm name county well located

LANDOWNER:

James Rea
Route 1, Myrtle
(mailing address)

description of fomations encountered

from to

<u>Shales</u>	<u>0</u>	<u>30</u>
<u>Rock & Sand</u>	<u>30</u>	<u>75</u>
<u>Blue mud</u>	<u>75</u>	<u>350</u>
<u>Rock & sand</u>	<u>350</u>	<u>420</u>

WELL LOCATION:

sec 17 T 7 N R 2 E
8 miles W of Place Allam
(distance) (direction) (nearest town)


WELL PURPOSE:

(home, irrigation, municipal, industrial) Home

WELL COMPLETION DATA:

- (1) diameter (inches) 4"
- (2) total depth (feet) 420'
- (3) static water level (feet) 70' below above top of ground.
- (4) casing Metal, 105'
(material) (depth)
4"
(size) if telescope see back.
- (5) screen None
(length) (depth to top)
(size) (material)
- (6) pump 1 1/2 6
(HP) (yield gpm)
Electric
(type power)
- (7) electric log No
(yes or no)
(organization running log)
- (8) how well bottom plugged No

CODED

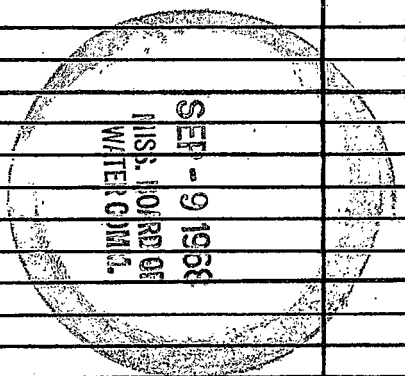

DRILLERS REMARKS:

