

**CODED**

600.00  
30.00  
00

**UNION**  
 FEB 9 1972  
**G 51**  
 MISS. BD. OF  
**1-18-72**

MISSISSIPPI  
 BOARD OF WATER COMMISSIONERS  
 416 North State Street  
 Jackson, Mississippi 39201

**CODED**

**WATER WELL DRILLERS LOG**

1-18 1972 JT Medlin Union  
 date well completed firm name county well located

LANDOWNER: <u>Charles Keegan</u>	description of formations encountered	from	to
(mailing address)			
<u>New Albany</u>	<u>W clay</u>	<u>0</u>	<u>18</u>
<u>Ingomar P#</u>	<u>Rock &amp; Clay</u>	<u>18</u>	<u>20</u>
	<u>Blaze</u>	<u>20</u>	<u>130</u>
	<u>Rock &amp; sand</u>	<u>130</u>	<u>200</u>

**WELL LOCATION:**  
 sec. 34 T 2 N R 2 W  
3 miles N.W. of Ingomar  
 (distance) (direction) (nearest town)

**WELL PURPOSE:**  
 (home, irrigation, municipal, industrial)

**WELL COMPLETION DATA:**

(1) diameter (inches) 4

(2) total depth (feet) 200

(3) static water level (feet) 18 below above top of ground.

(4) casing P 83  
 (material) (depth)  
 (size) if telescope see back.

(5) screen \_\_\_\_\_  
 (length) (depth to top)  
 (size) (material)

(6) pump 1/2 6  
 (HP) (yield gpm)  
E  
 (type power)

(7) electric log \_\_\_\_\_  
 (yes or no)  
 (organization running log)


(8) how well bottom plugged \_\_\_\_\_

**CODED**

**DRILLERS REMARKS:**

If well telescopes please sketch and show depths.

GROUND LEVEL

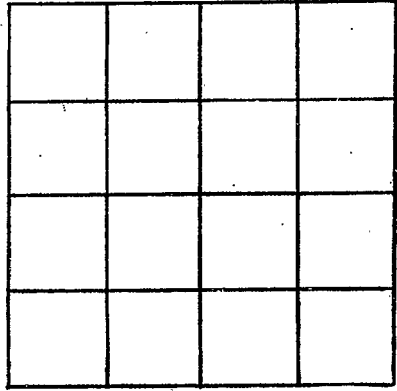

SECTION \_\_\_\_\_

Please indicate well location X.

ADDITIONAL INFORMATION

If more than one screen,  
show locations of each on sketch.