

UNION
G52
2-25-72

MISSISSIPPI
BOARD OF WATER COMMISSIONERS
416 North State St.
Jackson, Mississippi 39201

62500
3125
65625

CODED

WATER WELL DRILLERS LOG

225 19 72 J. J. Medlin WALKER
date well completed firm name county well located

LANDOWNER: Bull R. Kedge
New Albany
(mailing address)

description of formations encountered	from	to
	Clay	0
Rock & Sand	16	31
Clay	31	60
Blue " "	60	120
Rock & Sand	120	250

WELL LOCATION:
sec. 14 T. 7 N. R. 2 E
3 miles SW of New Albany
(distance) (direction) (nearest town)

WELL PURPOSE:
(home, irrigation, municipal, industrial)


- WELL COMPLETION DATA:
- (1) diameter (inches) 4
 - (2) total depth (feet) 250
 - (3) static water level (feet) 45 below top of ground.
 - (4) casing P 20 (material) (depth)
(size) if telescope see back.
 - (5) screen 0 (length) (depth to top)
(size) (material)
 - (6) pump 3/4 6 (HP) (yield gpm)
E (type power)
 - (7) electric log (yes or no)
 - (organization running log)
 - (8) how well bottom plugged and

CODED

DRILLERS REMARKS:

If well telescopes please sketch and show depths.

GROUND LEVEL

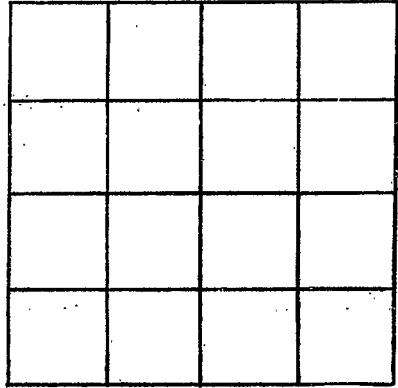

SECTION _____

Please indicate well location X.

ADDITIONAL INFORMATION

If more than one screen,
show locations of each on sketch.