

**UNION**  
**G54**  
**4-3-72**

MISSISSIPPI *lt. April 28-72*  
BOARD OF WATER COMMISSIONERS *June 12-72*  
416 North State Street  
Jackson, Mississippi 39201

WATER WELL DRILLERS LOG

**CODED**

*April 3* 19*72* *Jack Howell Well Co.* *Union*  
date well completed firm name county well located

LANDOWNER: *Bill Parkey*  
*Route # 4*  
*New Albany Miss*  
(mailing address)

description of formations encountered	from	to
<i>Clay dirt</i>	<i>0</i>	<i>21</i>
<i>Limestone Rock</i>	<i>31</i>	<i>39</i>
<i>Blue dirt</i>	<i>39</i>	<i>126</i>
<i>Sand</i>	<i>126</i>	<i>166</i>

WELL LOCATION:  
sec. *26* T. *7* N. R. *2* E  
*3* miles *SW* of *New Albany*  
(distance) (direction) (nearest town)

WELL PURPOSE: *Farm*  
(home, irrigation, municipal, industrial)

WELL COMPLETION DATA:

(1) diameter (inches) *6 in*

(2) total depth (feet) *166 ft*

(3) static water level (feet) *38* below above top of ground.

(4) casing *plastic*, *67 ft*,  
(material) (depth)

*6 in* If telescope see back.  
(size)

(5) screen *0*  
(length) (depth to top)

(size) (material)

(6) pump *3 Hammer*, *2.2*  
(HP) (yield gpm)

*electric*  
(type power)

(7) electric log (yes or no)

(organization running log)

(8) how well bottom plugged *Blue dirt*  
*Bottom*

**CODED**


APR 26 1972

MISS. BD. OF WATER COMMISSIONERS

DRILLERS REMARKS:

If well telescopes please sketch and show depths.

GROUND LEVEL

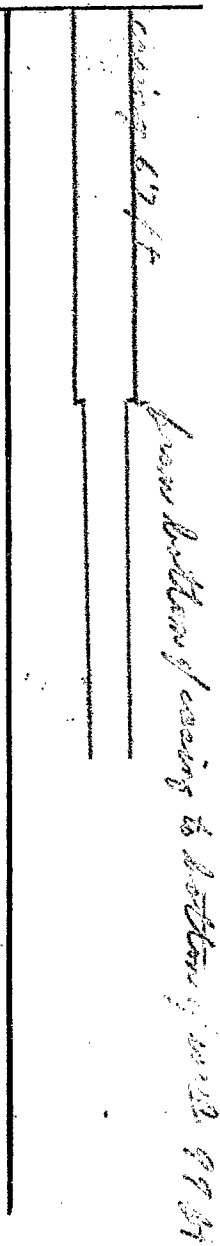


SECTION \_\_\_\_\_

Please indicate well location X.

ADDITIONAL INFORMATION

If more than one screen, show locations of each on sketch.