

UNION  
 G56  
 6-17-72

MISSISSIPPI  
 BOARD OF WATER COMMISSIONERS  
 416 North State Street  
 Jackson, Mississippi 39201

**CODED**

**WATER WELL DRILLERS LOG**

6-17-72 date well completed      Ed Clark firm name      Union county well located

**LANDOWNER:**  
 J.A. Thompson  
 Rt 1 Middle  
 (mailing address)

description of formations encountered	from	to
Argill	0	30
Red Clay	30	75
Rock & Gr	75	160
Blue mud	160	200
Rock & sand	200	264

**WELL LOCATION:**  
 sec 19 T 7 N R 2 E  
 8 miles SW of N. Albany  
 (distance) (direction) (nearest town)

**WELL PURPOSE:**  
 (home, irrigation, municipal, industrial)

- WELL COMPLETION DATA:**
- (1) diameter (inches) 4"
  - (2) total depth (feet) 264'
  - (3) static water level (feet) 30' below top of ground.
  - (4) casing Metal, 78'  
 (material) (depth)  
 4" (size) if telescope see back.
  - (5) screen None  
 (length) (depth to top)  
 (size) (material)
  - (6) pump 3/4 jet 6  
 (HP) (yield gpm)  
 Electric (type power)
  - (7) electric log No  
 (yes or no)  
 (organization running log)
  - (8) how well bottom plugged No

**CODED**


SEP 20 1972

**DRILLERS REMARKS:**

MISS. BD.  
 WATER COM.

If well telescopes please sketch and show depths.

GROUND LEVEL

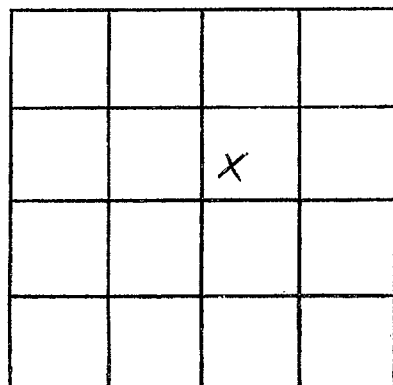

SECTION \_\_\_\_\_

Please indicate well location X.

ADDITIONAL INFORMATION

If more than one screen,  
show locations of each on sketch.