

UNION
G 58
3-31-72

MISSISSIPPI
BOARD OF WATER COMMISSIONERS
416 North State Street
Jackson, Mississippi 39201

CODED

WATER WELL DRILLERS LOG

March 31 1972 W. Ed Clark Union
date well completed firm name county well located

LANDOWNER:

James Giles
RT. 4 New Albany
(mailing address)

description of formations encountered

from to

<u>Shales</u>	<u>0</u>	<u>30</u>
<u>Red clay</u>	<u>30</u>	<u>70</u>
<u>Rock & sand</u>	<u>70</u>	<u>120</u>
<u>Blue mud</u>	<u>120</u>	<u>190</u>
<u>Rock & sand</u>	<u>190</u>	<u>242</u>

WELL LOCATION:

sec. 30 T. 7 N. R. 2 E
7 miles SW of Wiggins
(distance) (direction) (nearest town)

WELL PURPOSE:

Home
(home, irrigation, municipal, industrial)

WELL COMPLETION DATA:

- diameter (inches) 4"
- total depth (feet) 242'
- static water level (feet) 30' below top of ground.
- casing metal, 93'
(material) (depth)
4"
(size) if telescope see back.
- screen None
(length) (depth to top)
(size) (material)
- pump 1/2 HP 6
(HP) (yield gpm)
Electric
(type power)
- electric log no
(yes or no)
- organization running log
- how well bottom plugged no

CODED


SEP 20 1972

MISS. ED. OF
WATER COMMISSIONERS

DRILLERS REMARKS:

If well telescopes please sketch and show depths.

GROUND LEVEL

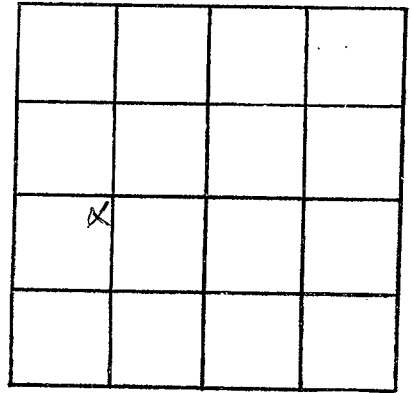

SECTION _____

Please indicate well location X.

ADDITIONAL INFORMATION

If more than one screen, show locations of each on sketch.