

Union

G59

7-28-72

MISSISSIPPI
 BOARD OF WATER COMMISSIONERS
 416 North State Street
 Jackson, Mississippi 39201

WATER WELL DRILLERS LOG

CODED

7-28-72
date well completed

Ed Clark
firm name

Union
county well located

LANDOWNER:

Ernest May
RT 4 New Albany
(mailing address)

description of formations encountered

from to

Frank	0	25
Red Clay	25	60
Blue mud	60	120
Rock + Sand	120	220

WELL LOCATION:

sec. 23 T. 7 N. R. 2 E.
7 miles S of New Albany
(distance) (direction) (nearest town)

WELL PURPOSE:

Home
(home, irrigation, municipal, industrial)

WELL COMPLETION DATA:

- (1) diameter (inches) 4"
- (2) total depth (feet) 220'
- (3) static water level (feet) 30 below above top of ground.
- (4) casing Metal, 90'
(material) (depth)
4" if telescope see back.
(size)
- (5) screen None
(length) (depth to top)
(size) (material)
- (6) pump 1/2 HP 6
(HP) (yield gpm)
Electric
(type power)
- (7) electric log Yes
(yes or no)
- (8) how well bottom plugged Yes

CODED


SEP 20 1972

DRILLERS REMARKS:

MRS. B. OF
WATER BOARD

If well telescopes please sketch and show depths.

GROUND LEVEL

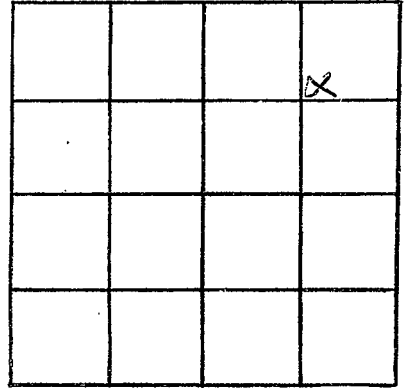

SECTION _____

Please indicate well location X.

ADDITIONAL INFORMATION

If more than one screen, show locations of each on sketch.