

UNION
G62
9-25-72

MISSISSIPPI
BOARD OF WATER COMMISSIONERS
416 North State Street
Jackson, Mississippi 39201

WATER WELL DRILLERS LOG

CODED

Sept 25 19 72 Ed Clade Union
date well completed firm name county well located

LANDOWNER:

William Freeman

New Albany Rt. 4
(mailing address)

WELL LOCATION:

sec 23 T 1 R 2 E
6 miles S of New Albany
(distance) (direction) (nearest town)

WELL PURPOSE: Domestic
(home, irrigation, municipal, industrial)

WELL COMPLETION DATA:

- (1) diameter (inches) 4"
- (2) total depth (feet) 200'
- (3) static water level (feet) 30' below above top of ground.
- (4) casing metal, 100'
(material) (depth)
4" if telescope see back.
(size)
- (5) screen none
(length) (depth to top)
(size) (material)
- (6) pump 1 gal 5
(HP) (yield gpm)
Electric
(type power)
- (7) electric log no
(yes or no)
(organization running log) no
- (8) how well bottom plugged

description of formations encountered

from to

<u>Domestic</u>	<u>0</u>	<u>25</u>
<u>Blue mud</u>	<u>25</u>	<u>60</u>
<u>Rock & Sand</u>	<u>60</u>	<u>120</u>
<u>Blue mud</u>	<u>120</u>	<u>145</u>
<u>Rock & Sand</u>	<u>145</u>	<u>200</u>


CODED

DRILLERS REMARKS:

DEC 4 1972

If well telescopes please sketch and show depths.

GROUND LEVEL

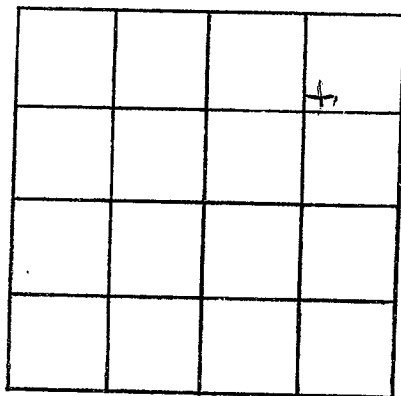

SECTION _____

Please indicate well location X.

ADDITIONAL INFORMATION

If more than one screen,
show locations of each on sketch.