

Union
G63
4-30-73

MISSISSIPPI
BOARD OF WATER COMMISSIONERS
416 North State Street
Jackson, Mississippi 39201

300.00
500
315.00
CODED

WATER WELL DRILLERS LOG

4 30 19 23 JT Medlin UNION
date well completed firm name county well located

LANDOWNER:
C.D. Brewer
New Albany
(mailing address)

description of formations encountered	from	to
Clay	0	12
blue " "	12	90
rock & clay	90	140
blue " "	140	165
rock & sand	165	300

WELL LOCATION:
sec. 11 T. 7 N. R. 2 E
4 miles W of New Albany
(distance) (direction) (nearest town)

WELL PURPOSE:
(home, irrigation, municipal, industrial)

- WELL COMPLETION DATA:
- (1) diameter (inches) 5
 - (2) total depth (feet) 300
 - (3) static water level (feet) 60 below top of ground.
 - (4) casing B 20 (material) (depth)
 - (size) if telescope see back.
 - (5) screen (length) (depth to top)
 - (size) (material)
 - (6) pump 10 (HP) (yield gpm)
 - (type power)
 - (7) electric log (yes or no)
 - (organization running log)
 - (8) how well bottom plugged


CODED

MISSISSIPPI BOARD OF WATER COMMISSIONERS

DRILLERS REMARKS:

If well telescopes please
sketch and show depths.

GROUND LEVEL

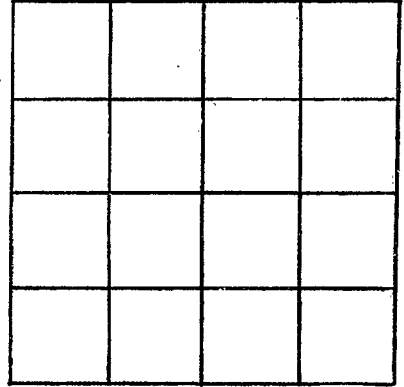

SECTION _____

Please indicate well location X.

ADDITIONAL INFORMATION

If more than one screen,
show locations of each on sketch.