

Union  
G 64  
5-18-73

MISSISSIPPI  
BOARD OF WATER COMMISSIONERS  
416 North State Street  
Jackson, Mississippi 39201

**CODED**

WATER WELL DRILLERS LOG

5-18-73 date well completed  
1973 Jumper Well Drilling Union firm name  
Union county well located


LANDOWNER:	description of formations encountered	from	to
Bruce Speck New Albany, Miss (mailing address)			
WELL LOCATION: sec. 2 T. 1 N. R. 2 E. S. 2 miles NW of New Albany (distance) (direction) (nearest town)	CLAY	50	150
WELL PURPOSE: (home, irrigation, municipal, industrial)	SAND + ROCK	150	240
WELL COMPLETION DATA: (1) diameter (inches) 4" (2) total depth (feet) 240 (3) static water level (feet) 40 below above top of ground. (4) casing PVC 100 (material) (depth) (size) if telescope see back. (5) screen (length) (depth to top) (size) (material) (6) pump 1/2 (HP) 8 (yield gpm) (type power) Elec. (7) electric log 0 (yes or no) (organization running log) (8) how well bottom plugged 0			
DRILLERS REMARKS:			

**CODED**

JUN 1973

If well telescopes please sketch and show depths.

GROUND LEVEL

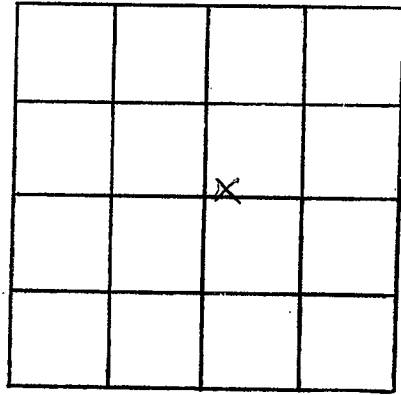

SECTION 2

Please indicate well location X.

ADDITIONAL INFORMATION

Lined area for additional information.

If more than one screen, show locations of each on sketch.